OPERATOR:	Colton Limited Liability Co	**CNTY:**	Adams	**FTG:**	2020 FNL and 800 FEL
WELL:	Linnebur Farms #42-1	**STATE:**	CO	**Q-Q:**	SENE
FIELD:	Barrel Ranch - #5300	**ROTARY SPUD:**	21-May-00	**SEC.:**	1
API #	05-001-09413	**COMP:**	7-Jul-00	**TWS:**	3S
LEASE #:	-	**STATUS:**	SI	**RGE:**	61W
UIC #:	-	**WBD DATE:**	14-Sep-21	**BY:**	RJD
BASIN:	Denver - Julesburg	**LAT/LONG:**	39.820910 / -104.154150		

IP GAS:	
IP OIL:	
IP WTR:	
CUM GAS:	
CUM OIL:	
CUM WTR:	
LAST PROD:	

WELLBORE DIAGRAM

KBE: 4999.0 '
KB: 10.0 '
GLE: 4989.0 '

TD (ft): 6660 '
PBTD (ft): 6639 '

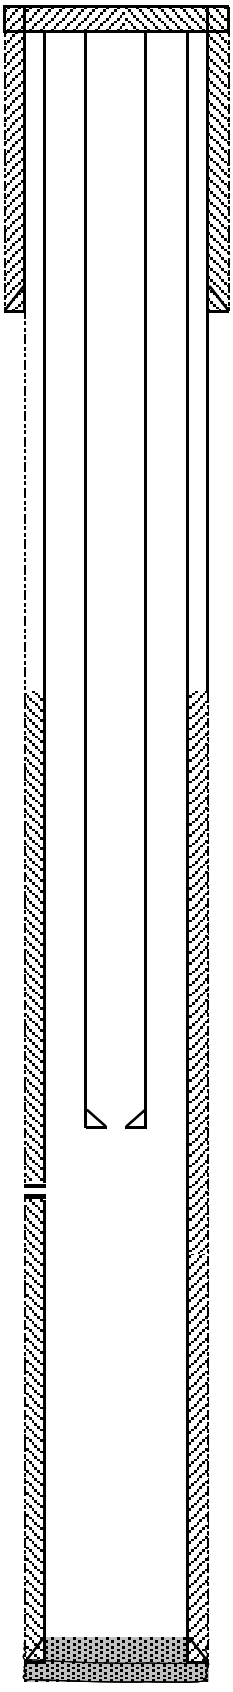

8 5/8" 24# Csg @ 639 '
w/ 450 sxs

CBL TOC @ 5624 '

Top Niobrara @ 5775 '
Top Fort Hays @ 6053 '
Top Carlile @ 6186 '
Top Bentonite @ 6365 '
Top D Sand @ 6469 '
Top Huntsman @ 6476 '

Top J Sand @ 6518 '
Top J2 Sand @ 6540 '

EOT @ 6439'?

J Sand 6480'-6516'

Top Skull Creek @ 6623 '

ORIG PBTD @ 6639 '
4 1/2" 11.6# Csg @ 6660 '
Cmtd w/ 200 sxs
TD @ 6660 '
7 7/8" Hole

CASING HEAD: Unknown
WELLHEAD: Unknown

CASING RECORD

HOLE (in)	SIZE (in)	WT (lb/ft)	GRADE	TOP (ft)	BTM (ft)	JTS
12 1/4	8 5/8	24		0	639	
7 7/8	4 1/2	11.6		0	6660	

Float Collar @

TUBING RECORD COND: DATE:

SIZE (in)	WT (lb/ft)	GRADE	TOP (ft)	TALLY (ft)	JTS	
RODS IN HOLE						est

ITEM	DESC	SIZE (in)	TALLY (ft)	JTS
K.B.				
HANGER				
TBG		2 3/8	6437.90	
SN			6439.00	
Notch Collar				
EOT @			12876.90	

PERFORATION RECORD

ZONE	TOP (ft)	BTM (ft)	SPF	DATE SHOT	STATUS	STIM
J Sand	6480	6516	1		ACIDIZE W/1000 GAL OF3# HCI MIXED W/4 GAL NE9 4 GAL CI-7 .5 GAL MAVHIB 3 1 GAL S-1, 10# LC-100 AND 75 7/8" BALL. FRAC W/36200 GAL MAVFRAC 35 X-LINK GEL CONTAINING 75380# 20/40 SAND.	

WELLWORK HISTORY