




**DRILLING COMPANY, INC.**  
**WICHITA, KANSAS**

**Proposed P&A Wellbore Diagram**

Set 15 sk plug at surface, 6 sks in 5-1/2" & 9 sks in the 5-1/2"-8-5/8" annulus.  
 Cut off 5' below G, weld cap w/name, legal location, API number & date.

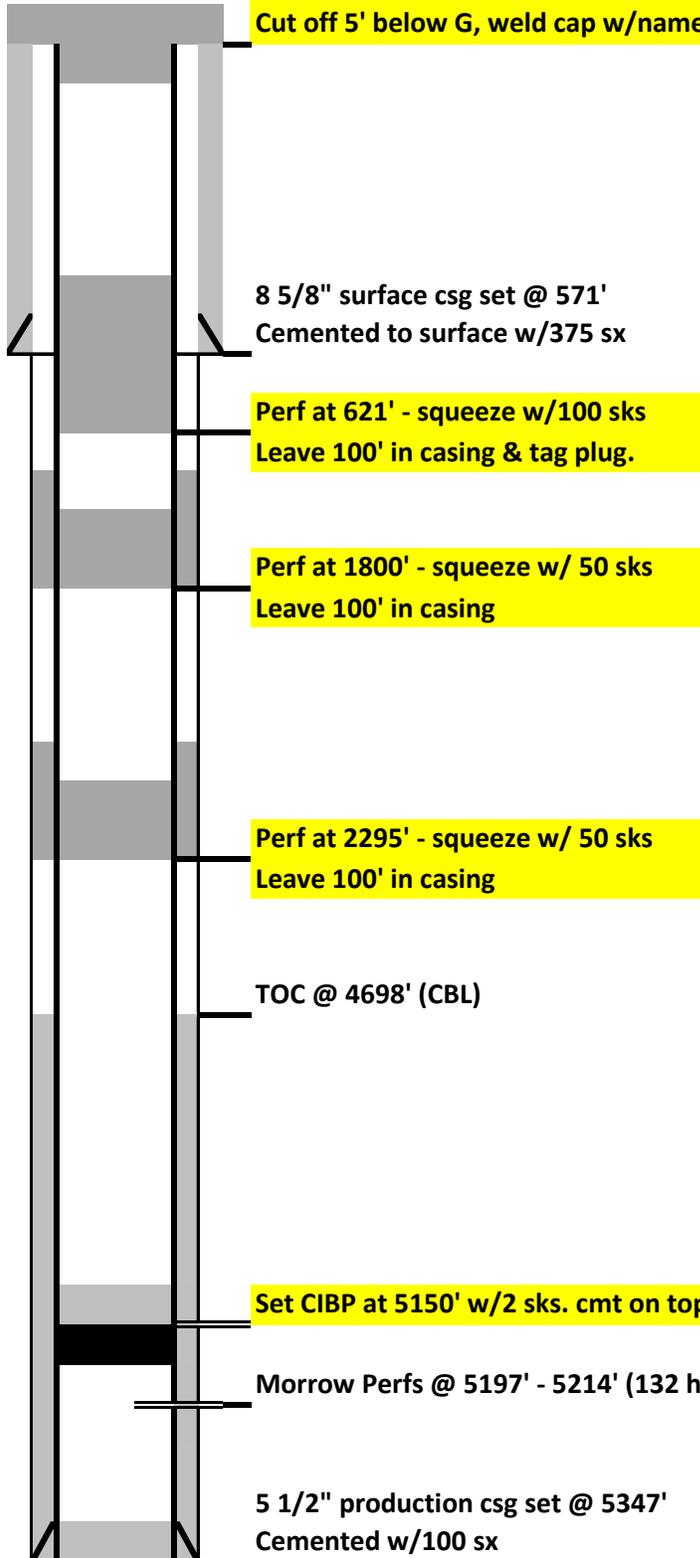

Date:	6/22/2021
Well Name:	Kern Farms "A" #1
Location:	1737' FNL & 460' FWL SW/4 NW/4 2-14S-42W
County:	Cheyenne
State:	Colorado
API:	05-017-07040-00
GL:	3927'
KB:	3939'
Spud Date:	10/16/1989
DFP Morrow:	11/30/1989

Formation	Log Top
NIOBRARA	686
FORT HAYS	1390
CODELL	1446
CARLILE	1460
GREENHORN	1625
DAKOTA	1820
CHEYENNE	2140
MORRISON	2245
BLAINE	2653
CEDAR HILLS	2765
SHAWNEE	4007
LANSING	4267
MARMATON	4654
CHEROKEE K	4815
MORROW	5107
KEYES	5225
ST LOUIS	5286

PBTD = 5252'  
 RTD = 5353'

5 1/2" production csg set @ 5347'  
 Cemented w/100 sx