# Schematic - Actual

**Well Name: Witwer 43-6** **TD: 7,080.0**

| API | Surface Legal Location | Field Name | State |
|---|---|---|---|
| 05123205180000 | NESE 6 5N 64W | Wattenberg | CO |
| **Well Configuration Type** | **Ground Elevation (ft)** | **Original KB Elevation (ft)** | **KB-Ground Distance (ft)** |
| Vertical | 4,610.00 | 4,622.00 | 12.00 |

**Most Recent Job**

| Job Category | Primary Job Type | Secondary Job Type | Start Date | End Date |
|---|---|---|---|---|
| Completion/Workover | | | 2/9/2018 | 2/12/2018 |
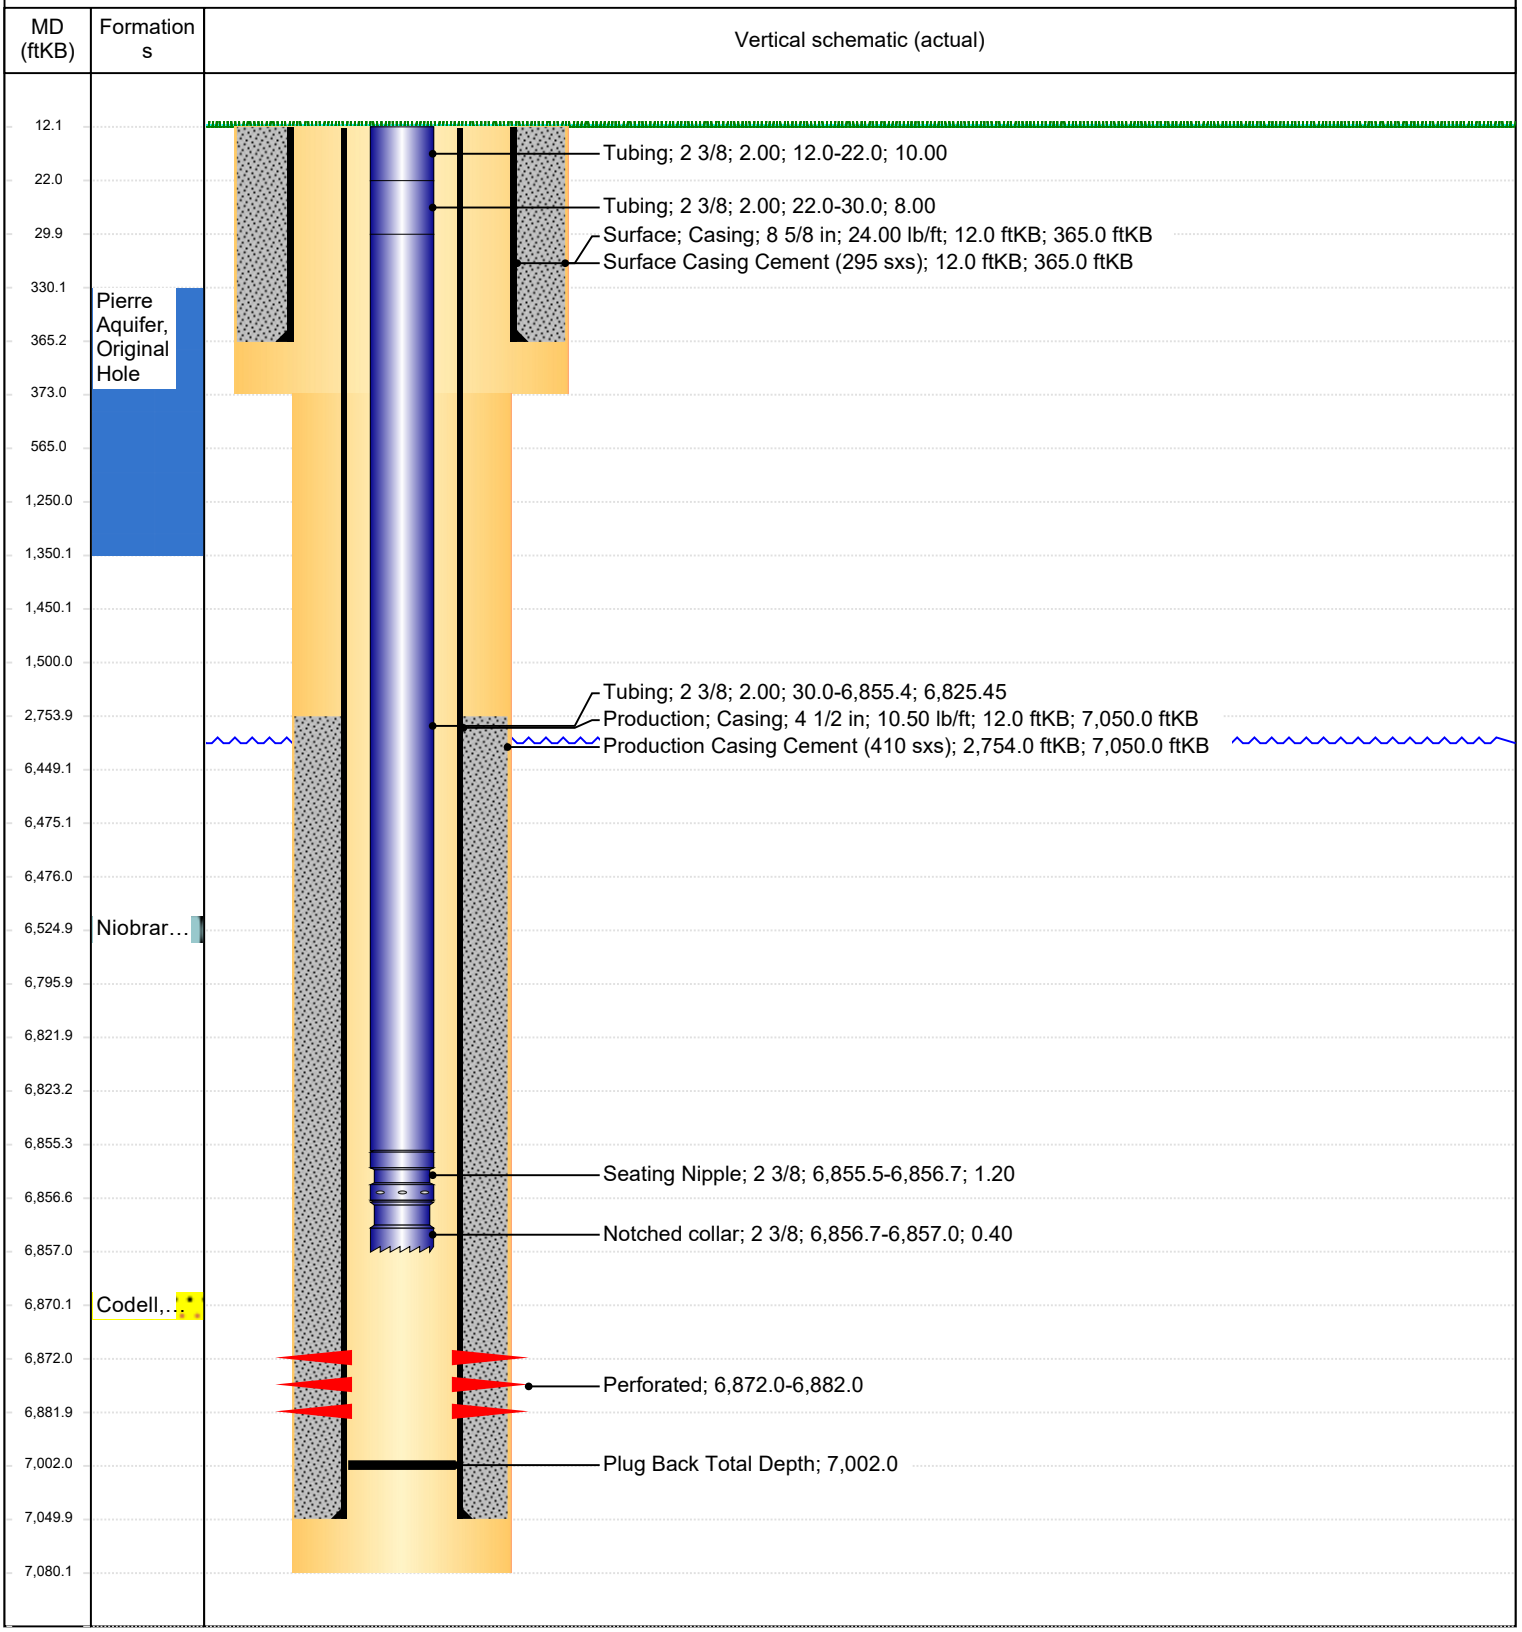
Vertical, Original Hole, 7/28/2021 10:55:11 PM