


Equity Oil & Gas  
Emerald 129  
API # 103-06014

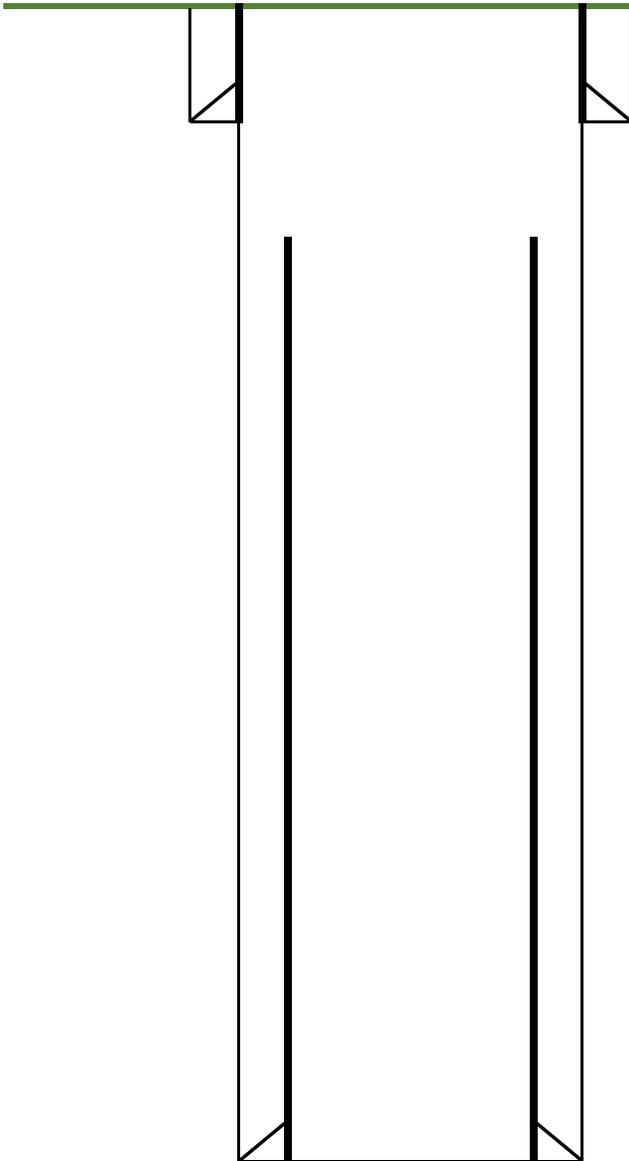

3' of cement on surface casing

10-3/4" Csg set @ Surface to 32'

7" Csg @ 200' to TD

TD @ 246' on caved in open hole  
From previous P&A

TD @ 3500' Original 12" open bore hole