


Well Name: UPRR 36 PAN AM C 1

VERTICAL, ORIGINAL HOLE, 10/13/2021 10:20:52 AM

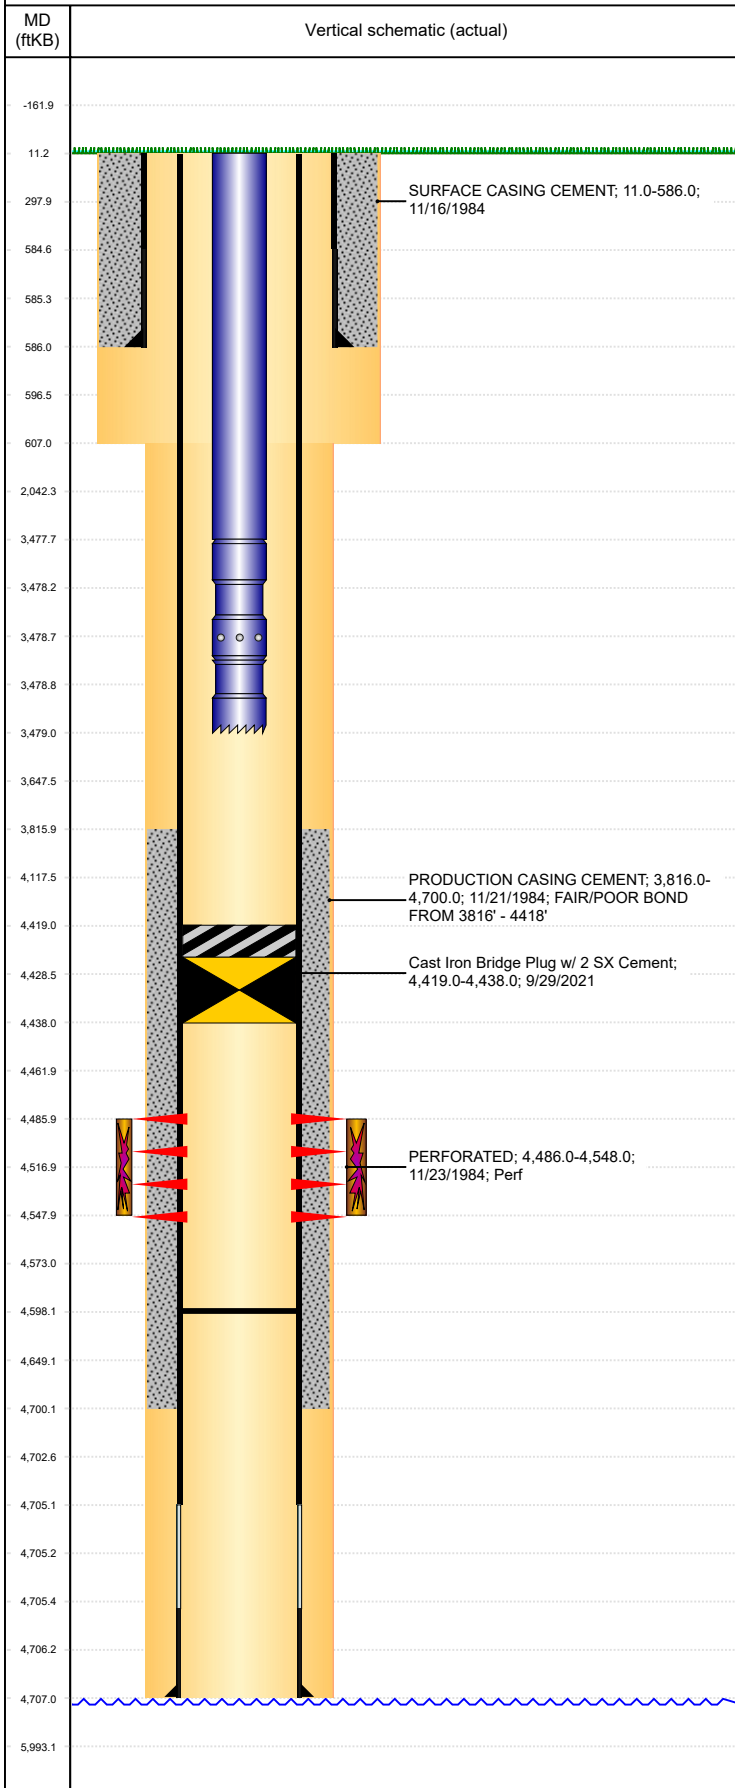

Well Header									
API 05-123-12174		Business Unit DJ BASIN			District 15		Well Config VERTICAL		
KB - GL / MSL (ft... 11.00		Spud Date 11/16/1984		P & A Date		Well Production Status TA			SoRT Yes
Comment WELL DATA IS SKETCHY IN WELL FILE AND ON STATE SITE.									
Surface Location (Congressional)									
Qtr 3 SW	Qtr 4 SW	Section 33	Twtnshp 4	Twtnsh... N	Range 65	Rng E/... W	Actual Latitude (°) 40.26324510	Actual Longitude (°) -104.67559190	
Wellbore Sections									
Section Des			Size (in)			Act Top, MD (ftKB)		Act Btm, MD (ftKB)	
SURFACE			12 1/4			11		607	
PRODUCTION			7 7/8			607		4,707	
Casing Strings									
Csg Des			Run Date		OD (in)	Wt/Len (lb/ft)	Grade	Top, MD (ftKB)	MD (ftKB)
Surface			11/16/1984		8 5/8	24.00		11.0	586.0
Production			11/21/1984		5 1/2	14.00	K-55	11.0	4,707.0
Cement									
Des					Start Date		Top (ftKB)		Btm (ftKB)
SURFACE CASING CEMENT					11/16/1984		11.0		586.0
PRODUCTION CASING CEMENT					11/21/1984		3,816.0		4,700.0
Zone Statuses									
Zone Name		Status Date	Status	Fluid Type	Job			Prod Method	
SUSSEX		3/25/2014	PR	Water				Flowing	
SUSSEX		9/29/2021	TA	Water					
Perforation Data									
Linked Zone			Bnch/Stg	Entered Shot Total	Top (ftKB)		Btm (ftKB)		Date
SUSSEX, ORIGINAL HOLE				248	4,486.00		4,548.00		11/23/1984
Stimulation Intervals									
Zone				Start Date		Top (ftKB)		Btm (ftKB)	
SUSSEX, ORIGINAL HOLE				2/18/1985		4,486.0		4,548.0	
Other In Hole									
Run Date		Des			Make	OD (in)	Top (ftKB)	Btm (ftKB)	
9/29/2021		Cast Iron Bridge Plug w/ 2 SX Cement				5	4,419.0	4,438.0	
Logs									
Date		Type					Top, MD (ftKB)		Btm, MD (ftKB)
11/19/1984		COMPENSATED NEUTRON					597.0		4,698.0
11/19/1984		INDUCTION					597.0		4,694.0
11/19/1984		LITHOLOGY CYBERLOOK					4,190.0		4,675.0
11/19/1984		SONIC					597.0		4,654.0
1/17/1985		CEMENT BOND					3,600.0		4,636.0
2/3/2018		GYRO					12.0		4,350.0
Plug Back Total Depths									
Date		Type			Com				Depth (ftKB)
1/17/1985		FILL			DEPTH LOGGER ON CBL				4,642.0
2/21/1985		FILL			TAG @ 4598'				4,598.0