

Rangely Weber Sand Unit

MCLAUGHLIN SW 4
Current Wellbore

Well Details:	
STATE & CO	CO - Rio Blanco
TWNS & RNG	TN002 & RW102
SECTION	(NESW) 33
API	51030107600
CHEVNO	DE6650

Casing Details:	
Type	Depth
KB	5224
GL	5214
16in. 60 #/ft, H-40	0-31', 4 YDS sxs cmt
10.75in. 40.5 #/ft, J-55	0-1001', 600 sxs cmt
7in. 23 #/ft, J-55	0-5608', 1250 sxs cmt
5in. 18 #/ft, L-80	5448-6249', 300 sxs cmt
Top Perf	5520
Bot Perf	6189
PBTD	6375
TD	6375

Formation	Depth
Niobrara	1919
Frontier	2644
Frontier Snd	2731
Mowry	2915
Dakota	3016
Morrison	3097
Curtis	3738
Entrada	3844
Carmel	3997
Navajo	4050
Chinle	4648
Shinarump	4782
Moenkopi	4855
Weber	5510

KB 5224
GL 5214
16in. 60 #/ft, H-40
0-31', 4 YDS sxs cmt

10.75in. 40.5 #/ft, J-55
0-1001', 600 sxs cmt

7in. 23 #/ft, J-55
0-5608', 1250 sxs cmt

5in. 18 #/ft, L-80
5448-6249', 300 sxs cmt

GOC_CALC	5554
----------	------

Cum HCPV


Weber 1a	5510	22%
Weber 2	5660	
Weber 3a	5670	37%
Weber 4	5768	
Weber 5a	5790	67%
Weber 6	5888	
Weber 7a	5897	83%
Weber 8	6004	
Weber 9a	6030	91%
Weber 10	6130	
Weber 11a	6147	100%

Top Perf 5520

Btm Perf 6189

OWC_CALC	6374
----------	------

PBTD 6375
TD 6375

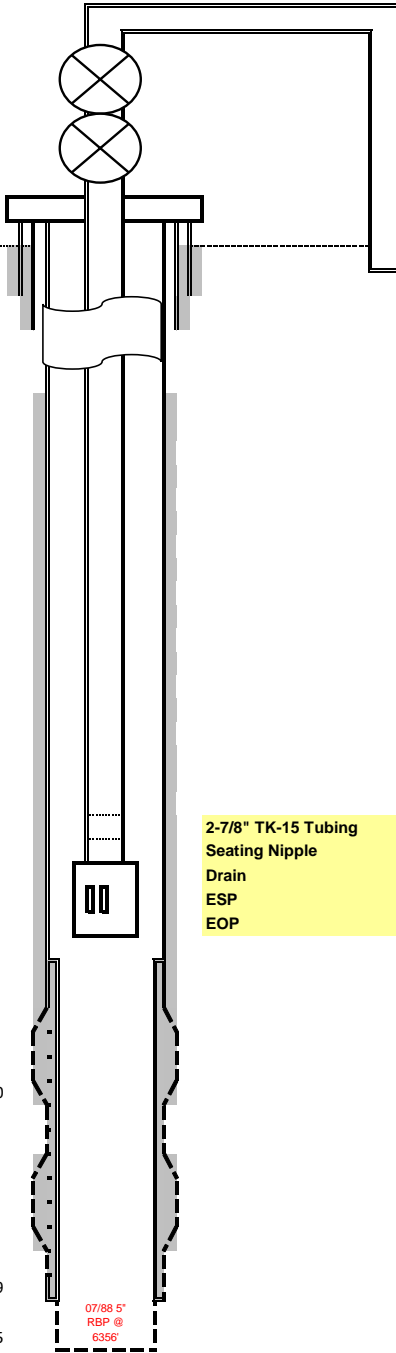

2-7/8" TK-15 Tubing	
Seating Nipple	5318
Drain	5382
ESP	5387
EOP	5424.5

****DOUBLE CHECK TUBING LANDING DETAIL IN WELL/TOUR FILE****

Notes:

- 1-
- 2-
- 3-
- 4-