


Well Name: MARIE D04-04

VERTICAL, ORIGINAL HOLE, 10/23/2021 10:27:34 AM

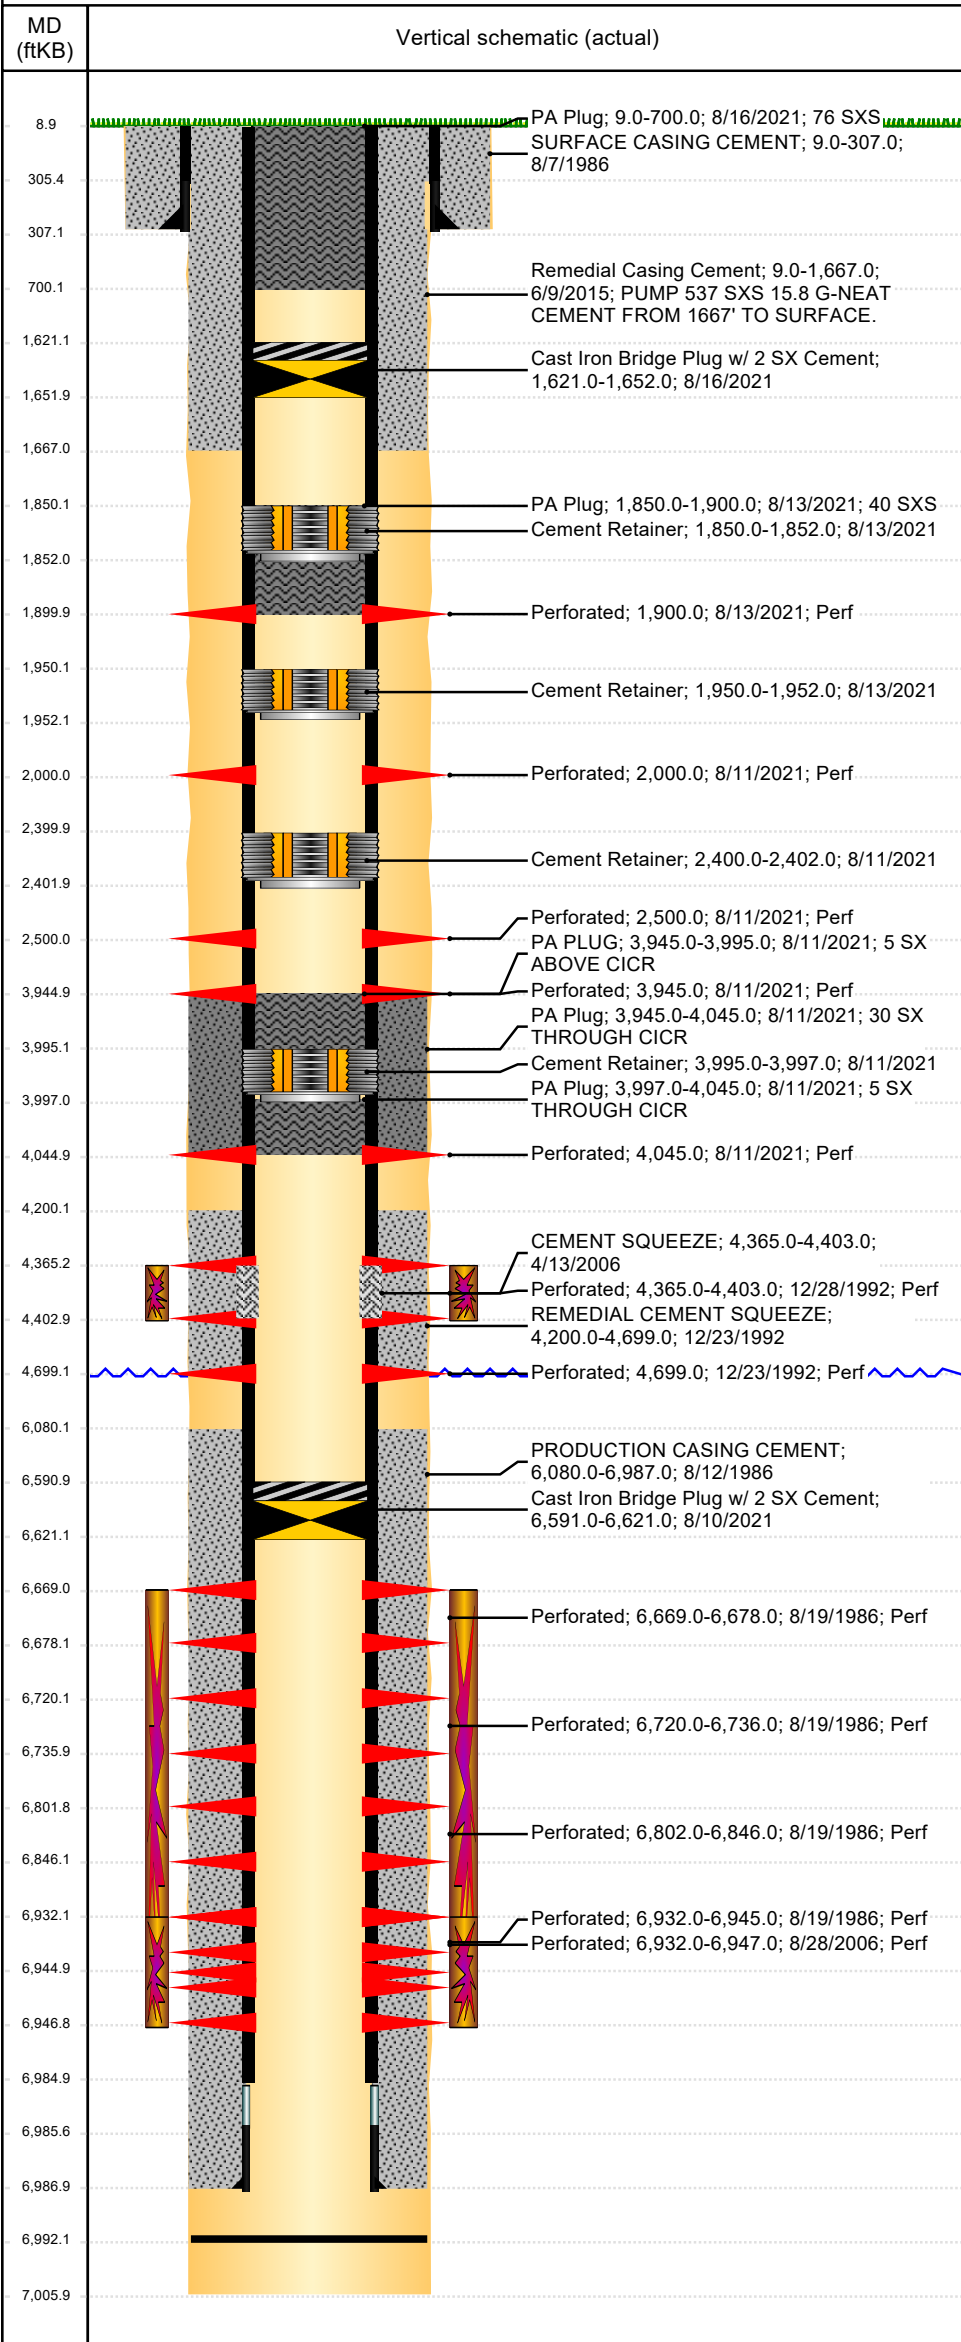

Well Header									
API 05-123-13111			Business Unit DJ BASIN			District 15		Well Configuration Type VERTICAL	
KB - GL / MSL (ftKB) 9.00		Spud Date 8/7/1986		P & A Date 9/22/2021		Well Production Status PA			SoRT Yes
Comment MISSING INITIAL DRILL REPORTS. INITIAL FRAC/STIM DATE ESTIMATED. DISCREPENCIES: TD- ST & LOGS 7006', SCHEMATIC 7051', USED 7006'; PROD CSG SET DEPTH- ST 6987', SCHEMATIC 7028', USED 6987' -- NO DATA IN FILE TO CONFIRM DEPTHS. STATE SHOWS SHUT IN SINCE SEP 2017.									
Surface Location (Congressional)									
Quarter 3 NW	Quarter 4 NW	Section 4	Township 3	Twnshp N N	Range 64	Rng E/W W	Actual Latitude (°) 40.25986894	Actual Longitude (°) -104.56313904	
Wellbore Sections									
Section Des			Size (in)			Act Top, MD (ftKB)		Act Btm, MD (ftKB)	
SURFACE			12 1/4			9		307	
PRODUCTION			7 7/8			307		7,006	
Casing Strings									
Csg Des			Run Date		OD (in)	Wt/Len (lb/ft)	Grade	Top, MD (ftKB)	MD (ftKB)
Surface			8/7/1986		8 5/8	24.00		9.0	307.0
Production			8/12/1986		4 1/2	15.10	N-80	9.0	6,987.0
Cement									
Des					Start Date		Top (ftKB)		Btm (ftKB)
SURFACE CASING CEMENT					8/7/1986		9.0		307.0
PRODUCTION CASING CEMENT					8/12/1986		6,080.0		6,987.0
REMEDIAL CEMENT SQUEEZE					12/23/1992		4,200.0		4,699.0
CEMENT SQUEEZE					4/13/2006		4,365.0		4,403.0
Remedial Casing Cement					6/9/2015		9.0		1,667.0
PA PLUG					8/11/2021		3,945.0		3,995.0
PA Plug					8/11/2021		3,997.0		4,045.0
PA Plug					8/11/2021		3,945.0		4,045.0
PA Plug					8/13/2021		1,850.0		1,900.0
					8/13/2021				
PA Plug					8/16/2021		9.0		700.0
Zone Statuses									
Zone Name	Status Date	Status	Fluid Type	Job				Prod Method	
NIOBRARA	3/15/2016	PR		HORIZONTAL WELL PREP, 6/2/2015 06:00					
NIOBRARA	8/10/2021	P&A		PLUG AND ABANDON, 8/10/2021 06:00					
SUSSEX	4/13/2006	AB		REMEDIAL CEMENTING, 4/11/2006 00:00					
SUSSEX	8/10/2021	P&A		PLUG AND ABANDON, 8/10/2021 06:00					
CODELL	3/15/2016	PR		HORIZONTAL WELL PREP, 6/2/2015 06:00					
CODELL	8/10/2021	P&A		PLUG AND ABANDON, 8/10/2021 06:00					
NIOBRARA-CODELL	8/10/2021	P&A		PLUG AND ABANDON, 8/10/2021 06:00					
Perforation Data									
Linked Zone		Bnch/Stg	Entered Shot Total	Top (ftKB)		Btm (ftKB)		Date	
SUSSEX, ORIGINAL HOLE			15	1,900.00		1,900.00		8/13/2021	
				2,000.00		2,000.00		8/11/2021	
				2,500.00		2,500.00		8/11/2021	
				3,945.00		3,945.00		8/11/2021	
				4,045.00		4,045.00		8/11/2021	
SUSSEX, ORIGINAL HOLE			1	4,365.00		4,403.00		12/28/1992	
			1	4,699.00		4,699.00		12/23/1992	
NIOBRARA, ORIGINAL HOLE			2	6,669.00		6,678.00		8/19/1986	
NIOBRARA, ORIGINAL HOLE			4	6,720.00		6,736.00		8/19/1986	
NIOBRARA, ORIGINAL HOLE			4	6,802.00		6,846.00		8/19/1986	
CODELL, ORIGINAL HOLE			60	6,932.00		6,947.00		8/28/2006	
CODELL, ORIGINAL HOLE			6	6,932.00		6,945.00		8/19/1986	
Stimulation Intervals									
Zone				Start Date		Top (ftKB)		Btm (ftKB)	
SUSSEX, ORIGINAL HOLE				12/30/1992		4,365.0		4,403.0	
NIOBRARA-CODELL, ORIGINAL HOLE				8/20/1986		6,669.0		6,945.0	
CODELL, ORIGINAL HOLE				9/21/2006		6,932.0		6,947.0	
Other In Hole									
Run Date		Des			Make		OD (in)	Top (ftKB)	Btm (ftKB)
8/10/2021		Cast Iron Bridge Plug w/ 2 SX Cement					3.826	6,591.0	6,621.0

Well Name: MARIE D04-04

VERTICAL, ORIGINAL HOLE, 10/23/2021 10:27:34 AM

Other In Hole

Run Date	Des	Make	OD (in)	Top (ftKB)	Btm (ftKB)
8/11/2021	Cement Retainer		3.826	2,400.0	2,402.0
8/11/2021	Cement Retainer		3.826	3,995.0	3,997.0
8/13/2021	Cement Retainer		3.826	1,950.0	1,952.0
8/13/2021	Cement Retainer		3.826	1,850.0	1,852.0
8/16/2021	Cast Iron Bridge Plug w/ 2 SX Cement		3.826	1,621.0	1,652.0

Logs

Date	Type	Top, MD (ftKB)	Btm, MD (ftKB)
8/11/1986	COMPENSATED DENSITY	3,700.0	7,046.0
8/11/1986	INDUCTION	307.0	7,046.0
8/14/1986	CEMENT BOND	5,868.0	6,921.0
12/22/1992	GAMMA RAY	4,100.0	4,880.0
6/10/2015	CBL/CCL/GR	9.0	2,000.0
6/15/2020	GYRO	100.0	6,900.0

Plug Back Total Depths

Date	Type	Com	Depth (ftKB)
6/3/2015	FILL		6,978.0
3/16/2016	FILL	NO C/O(46' OF RATHOLE)	6,992.0

