


**Well Name: GUTTERSEN D04-32**

VERTICAL, ORIGINAL HOLE, 10/24/2021 9:56:07 AM

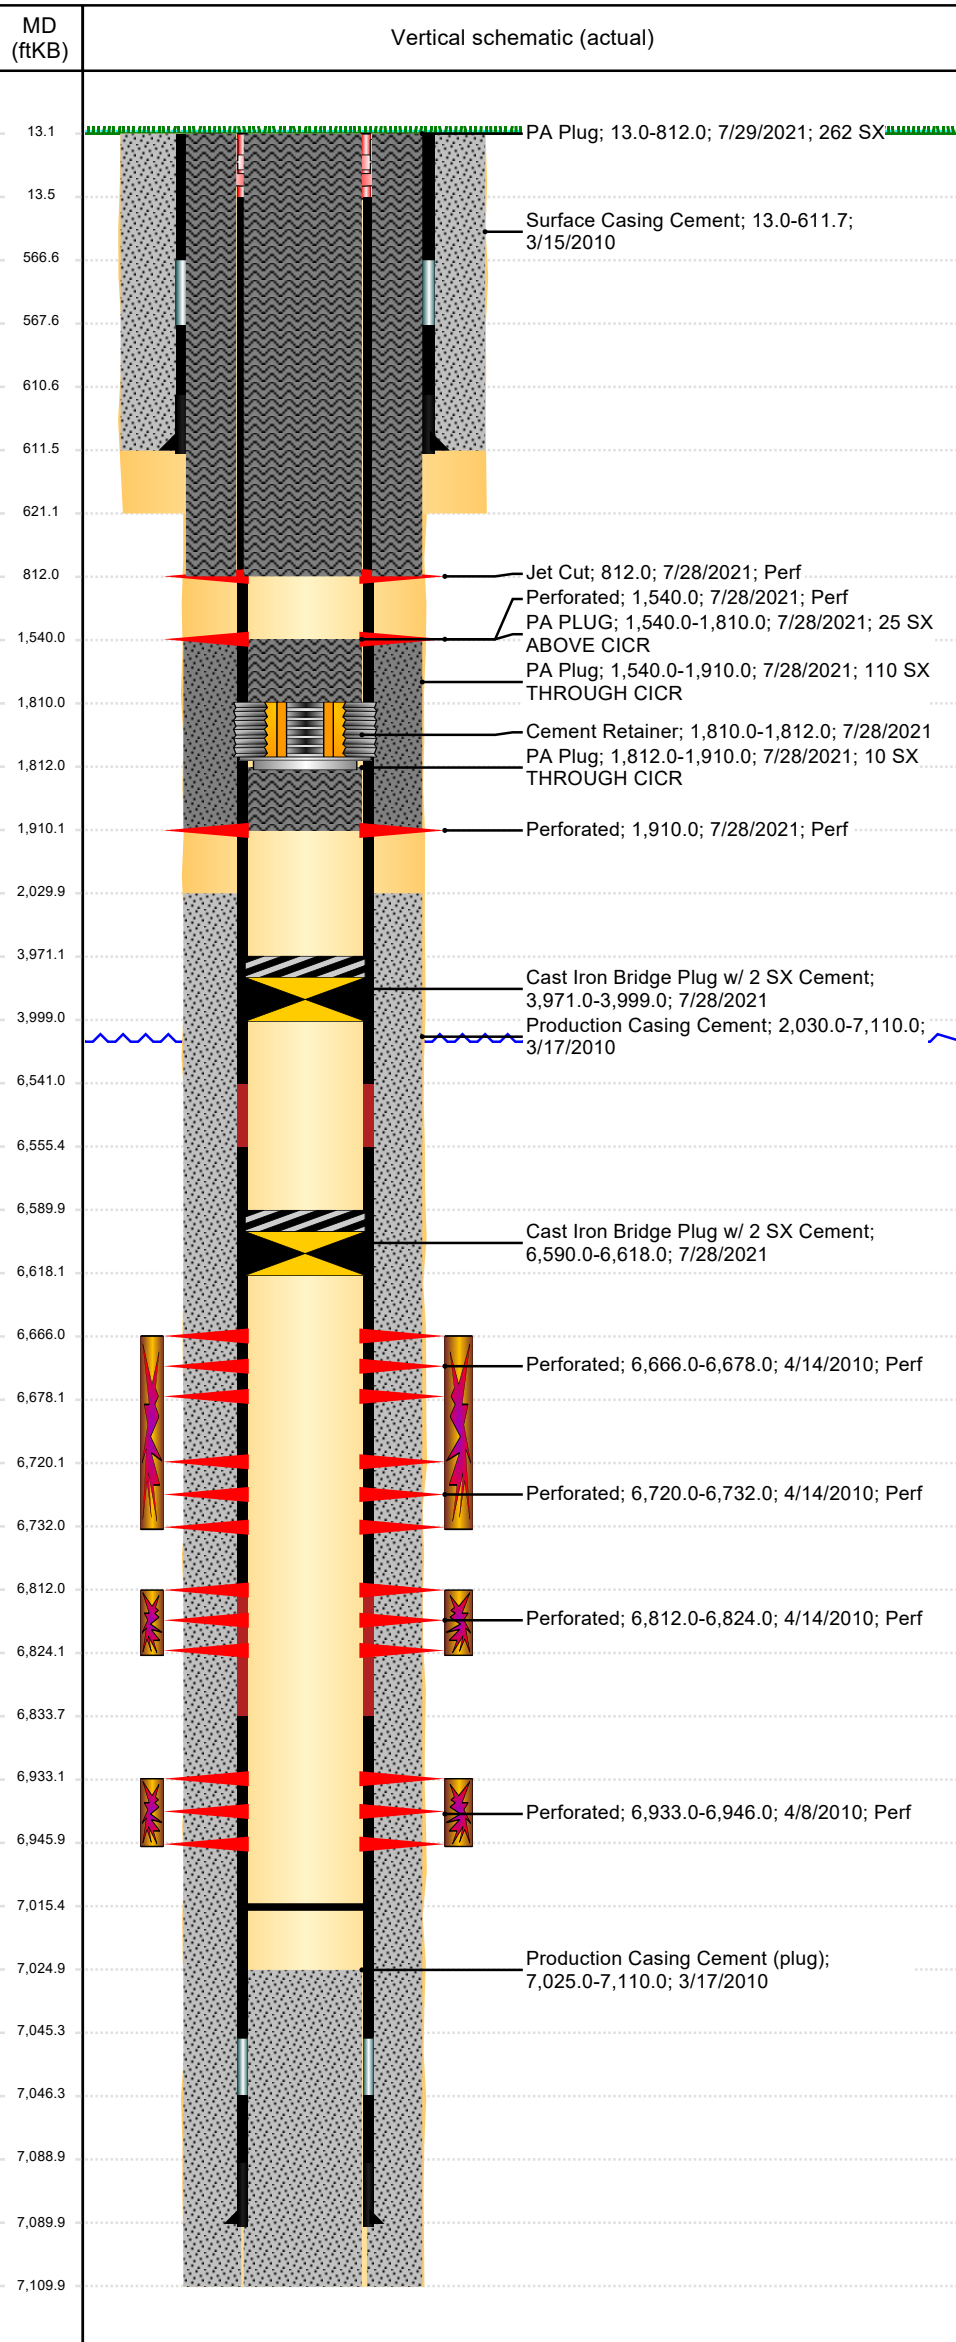

Well Header									
API 05-123-30201		Business Unit DJ BASIN			District 15		Well Configuration Type VERTICAL		
KB - GL / MSL (ftKB) 13.00		Spud Date 3/14/2010		P & A Date 9/23/2021		Well Production Status PA			SoRT Yes
Comment 318A.e. LOCATION!									
Surface Location (Congressional)									
Quarter 3 SW	Quarter 4 NW	Section 4	Township 3	Twtnshp N N	Range 64	Rng E/W W	Actual Latitude (°) 40.25492006		Actual Longitude (°) -104.56479230
Wellbore Sections									
Section Des			Size (in)			Act Top, MD (ftKB)		Act Btm, MD (ftKB)	
SURFACE			12 1/4			13		621	
PRODUCTION			7 7/8			621		7,110	
Casing Strings									
Csg Des			Run Date		OD (in)	Wt/Len (lb/ft)	Grade	Top, MD (ftKB)	MD (ftKB)
Surface			3/14/2010		8 5/8	32.00	J-55	13.0	611.7
Production			3/16/2010		4 1/2	11.60	N-80	13.0	7,090.0
Cement									
Des					Start Date		Top (ftKB)		Btm (ftKB)
Surface Casing Cement					3/15/2010		13.0		611.7
Production Casing Cement					3/17/2010		2,030.0		7,110.0
PA PLUG					7/28/2021		1,540.0		1,810.0
PA Plug					7/28/2021		1,812.0		1,910.0
PA Plug					7/28/2021		1,540.0		1,910.0
PA Plug					7/29/2021		13.0		812.0
Zone Statuses									
Zone Name	Status Date	Status	Fluid Type	Job				Prod Method	
NIOBRARA	5/9/2017	SI	Water	PLUG AND ABANDON, 7/27/2021 12:00				Flowing	
NIOBRARA	7/27/2021	P&A							
CODELL	1/26/2017	PR							
CODELL	7/27/2021	P&A							
Perforation Data									
Linked Zone		Bnch/Stg	Entered Shot Total	Top (ftKB)		Btm (ftKB)		Date	
		B	24	812.00		812.00		7/28/2021	
				1,540.00		1,540.00		7/28/2021	
				1,910.00		1,910.00		7/28/2021	
				6,666.00		6,678.00		4/14/2010	
NIOBRARA, ORIGINAL HOLE		A	24	6,720.00		6,732.00		4/14/2010	
NIOBRARA, ORIGINAL HOLE		C	24	6,812.00		6,824.00		4/14/2010	
CODELL, ORIGINAL HOLE			52	6,933.00		6,946.00		4/8/2010	
Stimulation Intervals									
Zone			Start Date			Top (ftKB)		Btm (ftKB)	
NIOBRARA, ORIGINAL HOLE			4/14/2010			6,666.0		6,732.0	
NIOBRARA, ORIGINAL HOLE			4/14/2010			6,812.0		6,824.0	
CODELL, ORIGINAL HOLE			4/14/2010			6,933.0		6,946.0	
Other In Hole									
Run Date	Des				Make	OD (in)	Top (ftKB)	Btm (ftKB)	
7/28/2021	Cast Iron Bridge Plug w/ 2 SX Cement					4	3,971.0	3,999.0	
7/28/2021	Cast Iron Bridge Plug w/ 2 SX Cement					4	6,590.0	6,618.0	
7/28/2021	Cement Retainer					4	1,810.0	1,812.0	
Logs									
Date		Type				Top, MD (ftKB)		Btm, MD (ftKB)	
3/16/2010		SPECTRAL DENSITY/Pe/DSN NEUTRON/SP/ARRAY COMPENSATED TRUE RESISTIVITY/6 ARM CALIPER				611.0		7,086.0	
3/16/2010		SPECTRAL GAMMA RAY				611.0		7,099.0	
3/31/2010		CBL/CCL/GR				1,830.0		7,025.0	
Plug Back Total Depths									
Date		Type		Com				Depth (ftKB)	
3/21/2010		CEMENT PLUG		CBL depth logger				7,025.0	
5/18/2015		BOTTOM OF TBG		RIH W/ 3 TAG JTS W/ NO TAG @ 7015.46				7,015.5	