


Well Name: MARIE D04-05

VERTICAL, ORIGINAL HOLE, 10/24/2021 10:54:28 AM

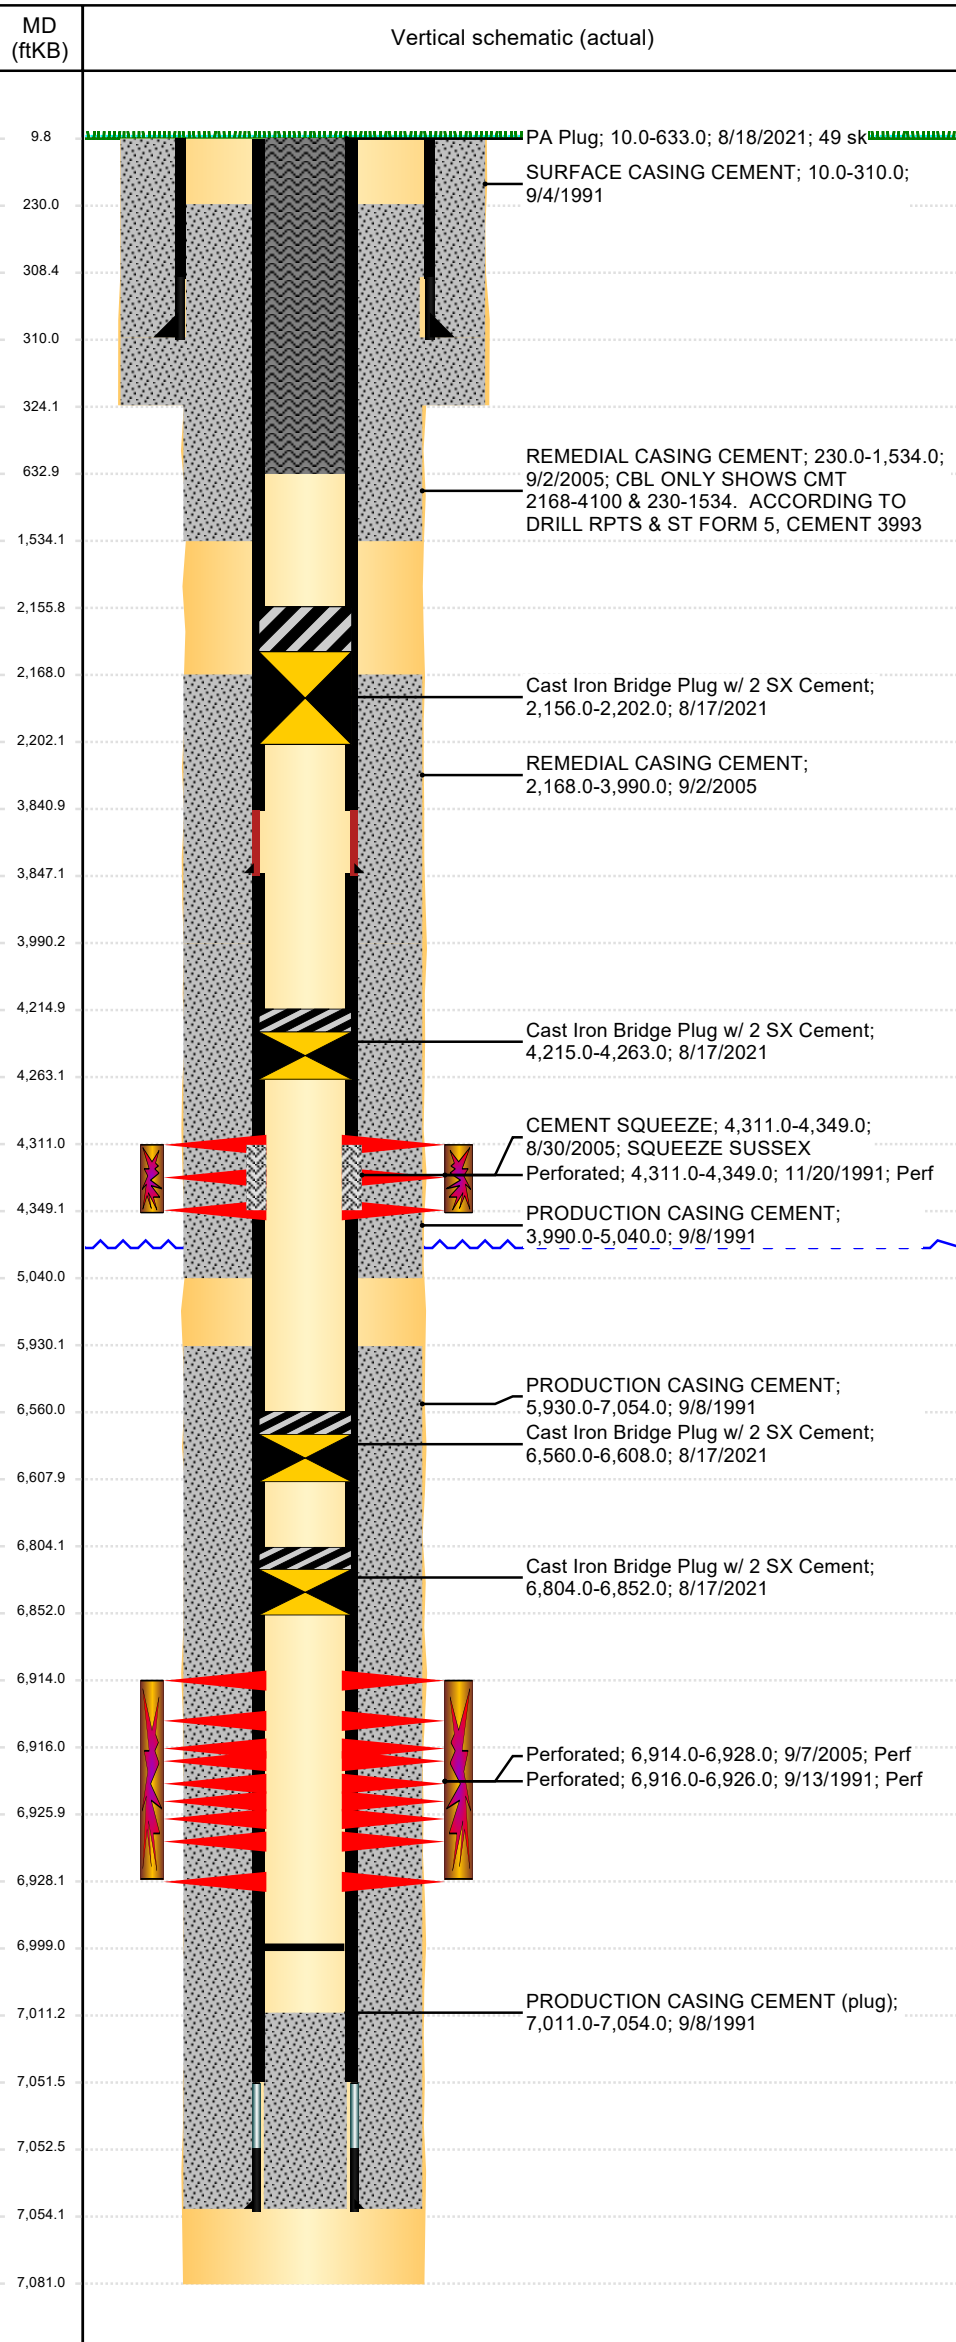

Well Header									
API 05-123-15121			Business Unit DJ BASIN			District 15		Well Configuration Type VERTICAL	
KB - GL / MSL (ftKB) 10.00		Spud Date 9/4/1991		P & A Date 9/23/2021		Well Production Status PA			SoRT Yes
Comment CSG RPR 9/2005 PATCH @3841'. DISCREPENCIES: TD- ST 7030', LOGS 7081'; PROD CSG SET DEPTH- ST 7081', DRL RPT 7054. CD PERF 1 SHOT @ 6900' NOT REPORTED ON ST FORM 5. REMEDIAL CMT- CBL ONLY SHOWS CMT 2168-4100 & 230-1534. ACCORDING TO DRILL RPTS & ST FORM 5, CEMENT 3993 TO SURFACE. FIELD OPS NOTICE- FLOWLINES ABANDONED, RCVD 6/29/17.									
Surface Location (Congressional)									
Quarter 3 SW	Quarter 4 NW	Section 4	Township 3	Twtnshp N	Range 64	Rng E/W W	Actual Latitude (°) 40.25630193		Actual Longitude (°) -104.56309363
Wellbore Sections									
Section Des			Size (in)			Act Top, MD (ftKB)		Act Btm, MD (ftKB)	
SURFACE			12 1/4			10		324	
PRODUCTION			7 7/8			324		7,081	
Casing Strings									
Csg Des		Run Date		OD (in)	Wt/Len (lb/ft)	Grade	Top, MD (ftKB)	MD (ftKB)	
Surface		9/4/1991		8 5/8	24.00	J-55	10.0	310.0	
Production		8/26/2005		3 1/2	9.20	L-80	10.0	3,847.0	
Production		9/8/1991		3 1/2	9.30	J-55	10.0	7,054.0	
Cement									
Des				Start Date		Top (ftKB)		Btm (ftKB)	
SURFACE CASING CEMENT				9/4/1991		10.0		310.0	
PRODUCTION CASING CEMENT				9/8/1991		3,990.0		5,040.0	
PRODUCTION CASING CEMENT				9/8/1991		5,930.0		7,054.0	
CEMENT SQUEEZE				8/30/2005		4,311.0		4,349.0	
REMEDIAL CASING CEMENT				9/2/2005		230.0		1,534.0	
REMEDIAL CASING CEMENT				9/2/2005		2,168.0		3,990.0	
PA Plug				8/18/2021		10.0		633.0	
Zone Statuses									
Zone Name	Status Date	Status	Fluid Type	Job				Prod Method	
CODELL	5/9/2017	SI		PLUG AND ABANDON, 8/16/2021 11:00 DRILLING/COMPLETION - ORIGINAL, 9/4/1991 00:00 RE-FRAC, 7/11/2005 00:00					
CODELL	8/16/2021	P&A							
SUSSEX	8/6/1992	PR							
SUSSEX	8/30/2005	AB							
Perforation Data									
Linked Zone		Bnch/Stg	Entered Shot Total	Top (ftKB)		Btm (ftKB)		Date	
SUSSEX, ORIGINAL HOLE			48	4,311.00		4,349.00		11/20/1991	
CODELL, ORIGINAL HOLE			56	6,914.00		6,928.00		9/7/2005	
CODELL, ORIGINAL HOLE			44	6,916.00		6,926.00		9/13/1991	
Stimulation Intervals									
Zone			Start Date		Top (ftKB)		Btm (ftKB)		
SUSSEX, ORIGINAL HOLE			11/21/1991		4,311.0		4,349.0		
CODELL, ORIGINAL HOLE			10/7/2005		6,914.0		6,928.0		
CODELL, ORIGINAL HOLE			10/7/1991		6,916.0		6,926.0		
Other In Hole									
Run Date	Des				Make	OD (in)	Top (ftKB)	Btm (ftKB)	
8/17/2021	Cast Iron Bridge Plug w/ 2 SX Cement					3	6,560.0	6,608.0	
8/17/2021	Cast Iron Bridge Plug w/ 2 SX Cement					3	4,215.0	4,263.0	
8/17/2021	Cast Iron Bridge Plug w/ 2 SX Cement					3	2,156.0	2,202.0	
8/17/2021	Cast Iron Bridge Plug w/ 2 SX Cement					3	6,804.0	6,852.0	
Logs									
Date	Type					Top, MD (ftKB)		Btm, MD (ftKB)	
9/8/1991	COMPENSATED DENSITY					4,100.0		7,078.0	
9/8/1991	INDUCTION					4,100.0		4,800.0	
9/8/1991	MICROLOG					4,100.0		4,800.0	
9/13/1991	CBL/CCL/GR					3,900.0		7,007.0	
9/6/2005	CBL/CCL/GR					0.0		4,150.0	
6/2/2020	GYRO					100.0		6,800.0	
Plug Back Total Depths									
Date	Type		Com						Depth (ftKB)
7/27/2015	FILL								6,998.0
3/21/2016	FILL		NO C/O(73' OF RATHOLE)						6,999.0