


# As Plugged Wellbore Diagram

## Well Header

Well Name MEDSKER 01-28	API 0500506515	Operator TRANS TEXAS ENERGY INC	Surface Legal Location NE/NE S28 T5S R65W	County ARAPAHOE
----------------------------	-------------------	---------------------------------------	--	--------------------

HORIZONTAL, Original Hole, 10/25/2021 9:54:55 AM

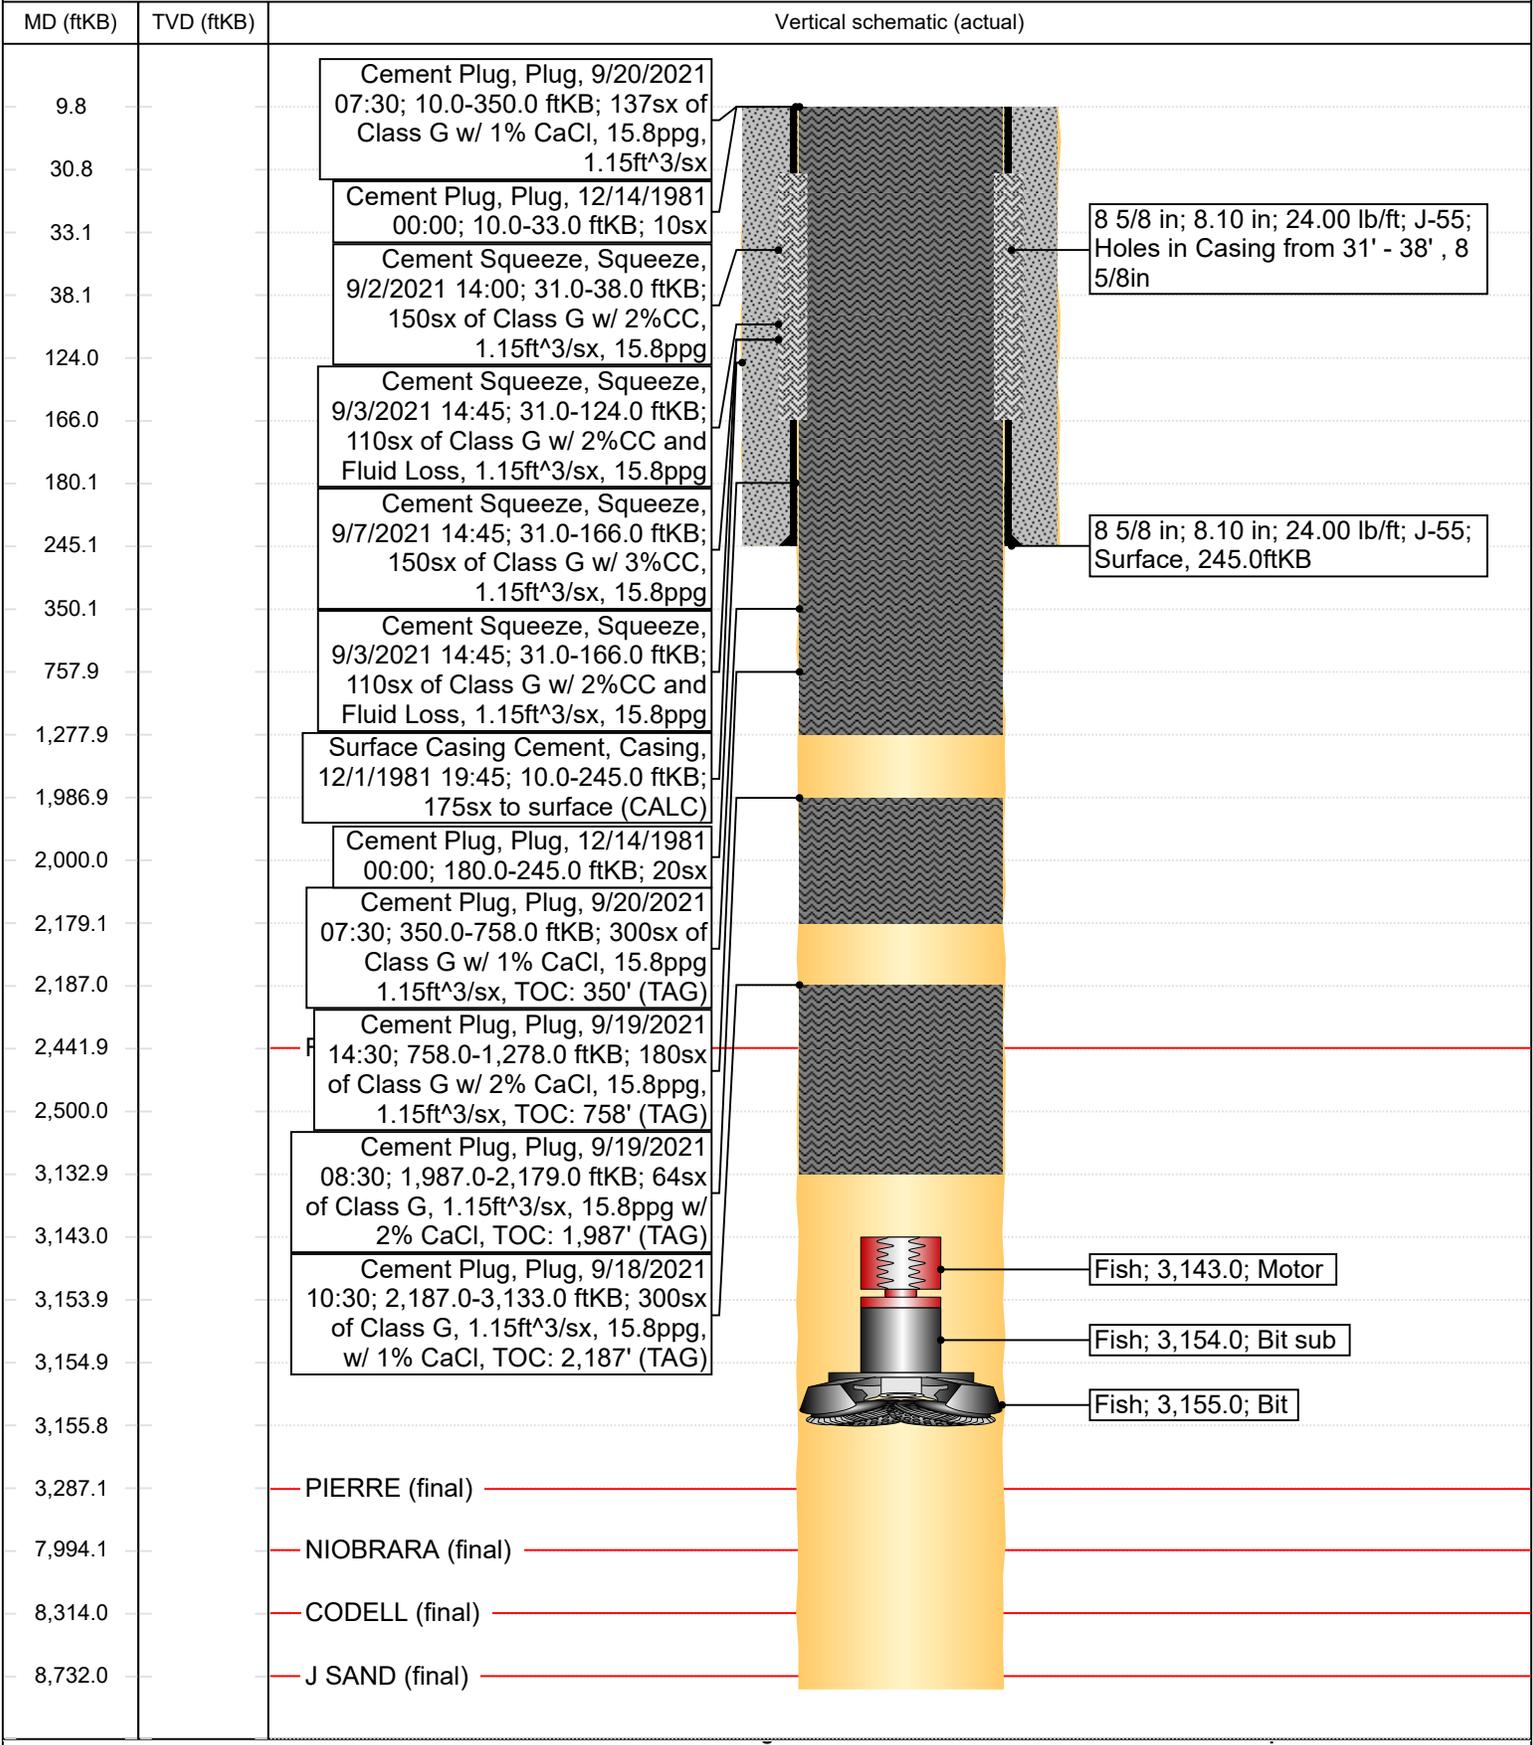

Cement Plug, Plug, 9/20/2021 07:30; 10.0-350.0 ftKB; 137sx of Class G w/ 1% CaCl, 15.8ppg, 1.15ft<sup>3</sup>/sx

Cement Plug, Plug, 12/14/1981 00:00; 10.0-33.0 ftKB; 10sx

Cement Squeeze, Squeeze, 9/2/2021 14:00; 31.0-38.0 ftKB; 150sx of Class G w/ 2%CC, 1.15ft<sup>3</sup>/sx, 15.8ppg

Cement Squeeze, Squeeze, 9/3/2021 14:45; 31.0-124.0 ftKB; 110sx of Class G w/ 2%CC and Fluid Loss, 1.15ft<sup>3</sup>/sx, 15.8ppg

Cement Squeeze, Squeeze, 9/7/2021 14:45; 31.0-166.0 ftKB; 150sx of Class G w/ 3%CC, 1.15ft<sup>3</sup>/sx, 15.8ppg

Cement Squeeze, Squeeze, 9/3/2021 14:45; 31.0-166.0 ftKB; 110sx of Class G w/ 2%CC and Fluid Loss, 1.15ft<sup>3</sup>/sx, 15.8ppg

Surface Casing Cement, Casing, 12/1/1981 19:45; 10.0-245.0 ftKB; 175sx to surface (CALC)

Cement Plug, Plug, 12/14/1981 00:00; 180.0-245.0 ftKB; 20sx

Cement Plug, Plug, 9/20/2021 07:30; 350.0-758.0 ftKB; 300sx of Class G w/ 1% CaCl, 15.8ppg 1.15ft<sup>3</sup>/sx, TOC: 350' (TAG)

Cement Plug, Plug, 9/19/2021 14:30; 758.0-1,278.0 ftKB; 180sx of Class G w/ 2% CaCl, 15.8ppg, 1.15ft<sup>3</sup>/sx, TOC: 758' (TAG)

Cement Plug, Plug, 9/19/2021 08:30; 1,987.0-2,179.0 ftKB; 64sx of Class G, 1.15ft<sup>3</sup>/sx, 15.8ppg w/ 2% CaCl, TOC: 1,987' (TAG)

Cement Plug, Plug, 9/18/2021 10:30; 2,187.0-3,133.0 ftKB; 300sx of Class G, 1.15ft<sup>3</sup>/sx, 15.8ppg, w/ 1% CaCl, TOC: 2,187' (TAG)

8 5/8 in; 8.10 in; 24.00 lb/ft; J-55; Holes in Casing from 31' - 38' , 8 5/8in

8 5/8 in; 8.10 in; 24.00 lb/ft; J-55; Surface, 245.0ftKB

Fish; 3,143.0; Motor

Fish; 3,154.0; Bit sub

Fish; 3,155.0; Bit

PIERRE (final)

NIOBRARA (final)

CODELL (final)

J SAND (final)