


Well Name: STEPHENS J31-16

VERTICAL, ORIGINAL HOLE, 10/25/2021 4:05:33 PM

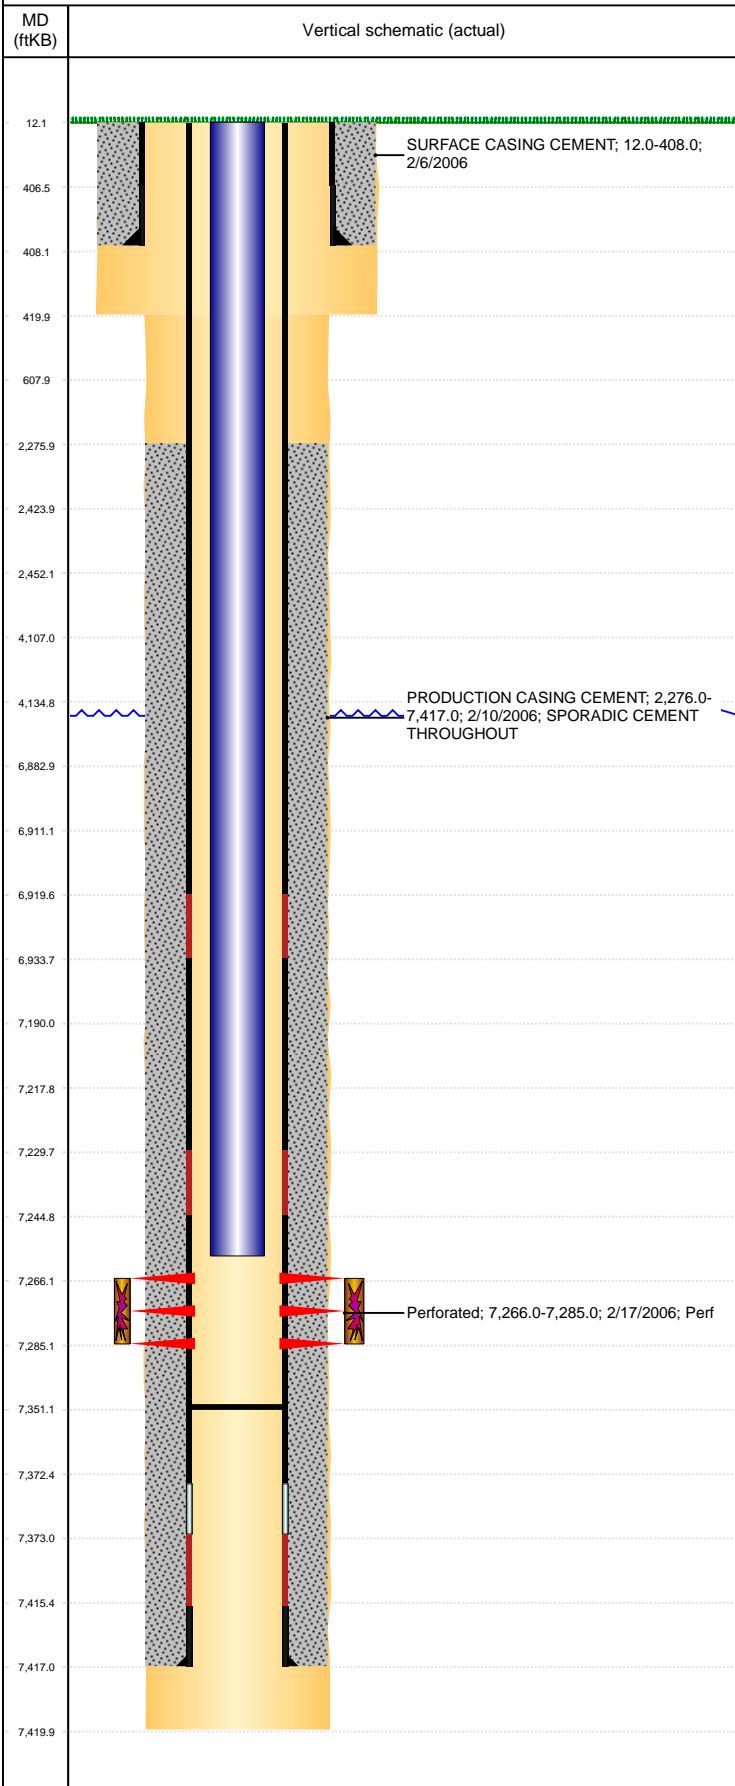

Well Header									
API 05-123-23227		Business Unit DJ BASIN			District 15		Well Config VERTICAL		
KB - GL / MSL (ft... 12.00		Spud Date 2/5/2006		P & A Date		Well Production Status SI		SoRT No	
Comment DISCREPANCY: DR RPT TD DATE 2/9/2006; ST RPT TD DATE 2/10/2006. STATE SHOWS SHUT IN SINCE MAR 2017.									
Surface Location (Congressional)									
Qtr 3 SE	Qtr 4 SE	Section 31	Twnshp 5	Twnsh... N	Range 66	Rng E/... W	Actual Latitude (°) 40.35036062	Actual Longitude (°) -104.81501376	
Wellbore Sections									
Section Des			Size (in)			Act Top, MD (ftKB)		Act Btm, MD (ftKB)	
SURFACE			12 1/4			12		420	
PRODUCTION			7 7/8			420		7,420	
Casing Strings									
Csg Des		Run Date		OD (in)	Wt/Len (lb/ft)	Grade	Top, MD (ftKB)	MD (ftKB)	
Surface		2/6/2006		8 5/8	24.00		12.0	408.0	
Production		2/10/2006		4 1/2	11.60	M-80	12.0	7,417.0	
Cement									
Des				Start Date		Top (ftKB)		Btm (ftKB)	
SURFACE CASING CEMENT				2/6/2006		12.0		408.0	
PRODUCTION CASING CEMENT				2/10/2006		2,276.0		7,417.0	
Zone Statuses									
Zone Name		Status Date	Status	Fluid Type	Job			Prod Method	
CODELL		2/23/2010	PR	Water				Flowing	
CODELL		3/10/2017	SI						
Perforation Data									
Linked Zone		Bnch/Stg	Entered Shot Total	Top (ftKB)		Btm (ftKB)		Date	
CODELL, ORIGINAL HOLE			76	7,266.00		7,285.00		2/17/2006	
Stimulation Intervals									
Zone				Start Date		Top (ftKB)		Btm (ftKB)	
CODELL, ORIGINAL HOLE				3/3/2006		7,266.0		7,285.0	
Other In Hole									
Run Date		Des			Make	OD (in)	Top (ftKB)	Btm (ftKB)	
Logs									
Date		Type				Top, MD (ftKB)		Btm, MD (ftKB)	
2/10/2006		COMPENSATED DENSITY				2,500.0		7,399.0	
2/10/2006		INDUCTION				408.0		7,419.0	
2/15/2006		CBL/CCL/GR				5,700.0		7,347.0	
Plug Back Total Depths									
Date		Type		Com				Depth (ftKB)	
2/10/2006		FLOAT COLLAR		TOP OF FLOAT COLLAR				7,373.0	
2/15/2006		FILL		DEPTH LOGGER ON CBL				7,351.0	