


Date: 9/21/2011
Preparer: Susan/REP

Wellname: SECU 405
Field: Campo
County: Baca State: CO
aka: Kearley A#5
API: 05-009-06383

QTR: NENE
Sec: 2
Twp: 35S
Rge: 46W
automatic

KB: 4214
GL: 4204
Diff: 10

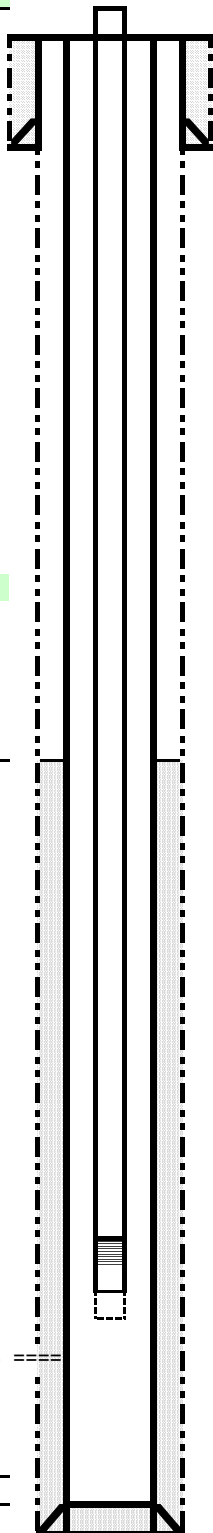

Casing Information

Size	Weight	Grade	Thread	Top	Btm	Date Run
8 5/8	24	K55	8rd	0	1561	10/8/1983
5 1/2	14	K55	8rd ST&C	0	4252	10/16/1983
DV tool					none	

Tubing Information

Size or Item	Weight	Grade	Thread	Depth	# of jts	Date Run
Centrilift mtr				3779		3/10/1999
Centrilift seal intake				3747		3/10/1999
Centrilift pump						3/10/1999
2 3/8					120	3/10/1999

Producing Intervals

Formation	Top	Btm	SPF	# of holes	Date Shot	Status
Lansing C	4010	4015	4	20	10/25/1983	open
				0		

Well History

10/8/1983	Cmt surf w/ 650 sks 65/35 pozmix & 150 sks Class H; cmt circ to surf
10/16/1983	Cmt prod csg w/ 175 sks 50/50 pozmix + 18% salt; good circ through job
10/20-22/83	Run CBL, TOC @ 3308; tag btm @ 4210 PBTD w/ tbg; PT 1000 psig, held 30, ok.
10/25-28/83	Perf Lansing 4010-4015 w/ 4 spf; swab test

DV tool none

TOC CBL 3308

Lansing C 4010-4015

Fill 4180
PBTD 4210
RTD 4253
OHTD