Date:	8/14/2009	Wellname:	SECU 603	QTR:	NESW
Preparer:	Susan/REP	Field:	Campo	Sec:	1
		County:	Baca State: CO	Twp:	35S
		aka:	Comanche Federal A #3	Rge:	46W
		API:	05-009-06496		automatic

KB:	4163
GL:	4152
Diff:	11

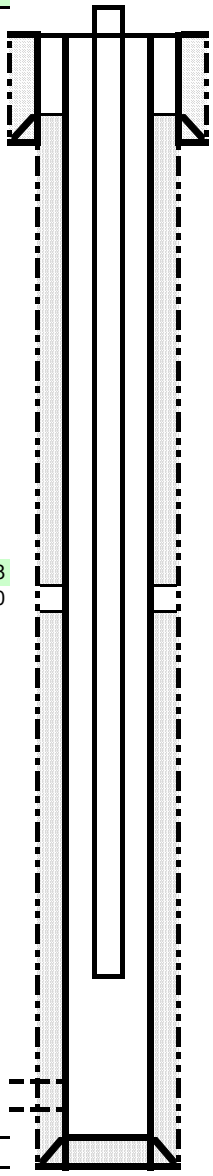

TOC	1800
8 5/8	1829
DV tool	3108
TOC CBL	3120
Lansing C	3932-3946
PBTD	4189
5 1/2	4249
RTD	4250

Casing Information

Size	Weight	Grade	Thread	Top	Btm	Date Run
8 5/8	24	K55	8rd ST&C	0	1829	11/7/1991
5 1/2	14	K55	ST&C	0	4249	12/16/1991
DV tool					3108	12/16/1991

Producing Intervals

Formation	Top	Btm	SPF	# of holes	Date Shot	Status
Lansing C	3932	3946	4	56	12/21/1991	open

Well History

11/7/1991	Cmt surf w/ 600 sks 65/35 pozmix (12.2 ppg) & 125 sks Class C (14.8 ppg);
	cmt fell; 1" w/ 10 sks Class H (15.3 ppg)
12/16/1991	Cmt prod csg 1st stage w/ 375 sks 50/50 pozmix (14.6 ppg) & 2nd stage w/ 345
	sks 65/35 pozmix cmt (12.2 ppg) & 300 sks 50/50 pozmix (13.8 ppg); circ 110 sks to pit
12/18-19/91	Drill out DV; tag PBTD @ 4189; PT csg to 1000 psig, held 15 min; run CBL & CET
12/21-27/1991	Perf w/ TCP @ 3932-3946 w/ 4 spf;