


Well Name: MARIE D04-23

VERTICAL, ORIGINAL HOLE, 10/30/2021 9:31:06 AM

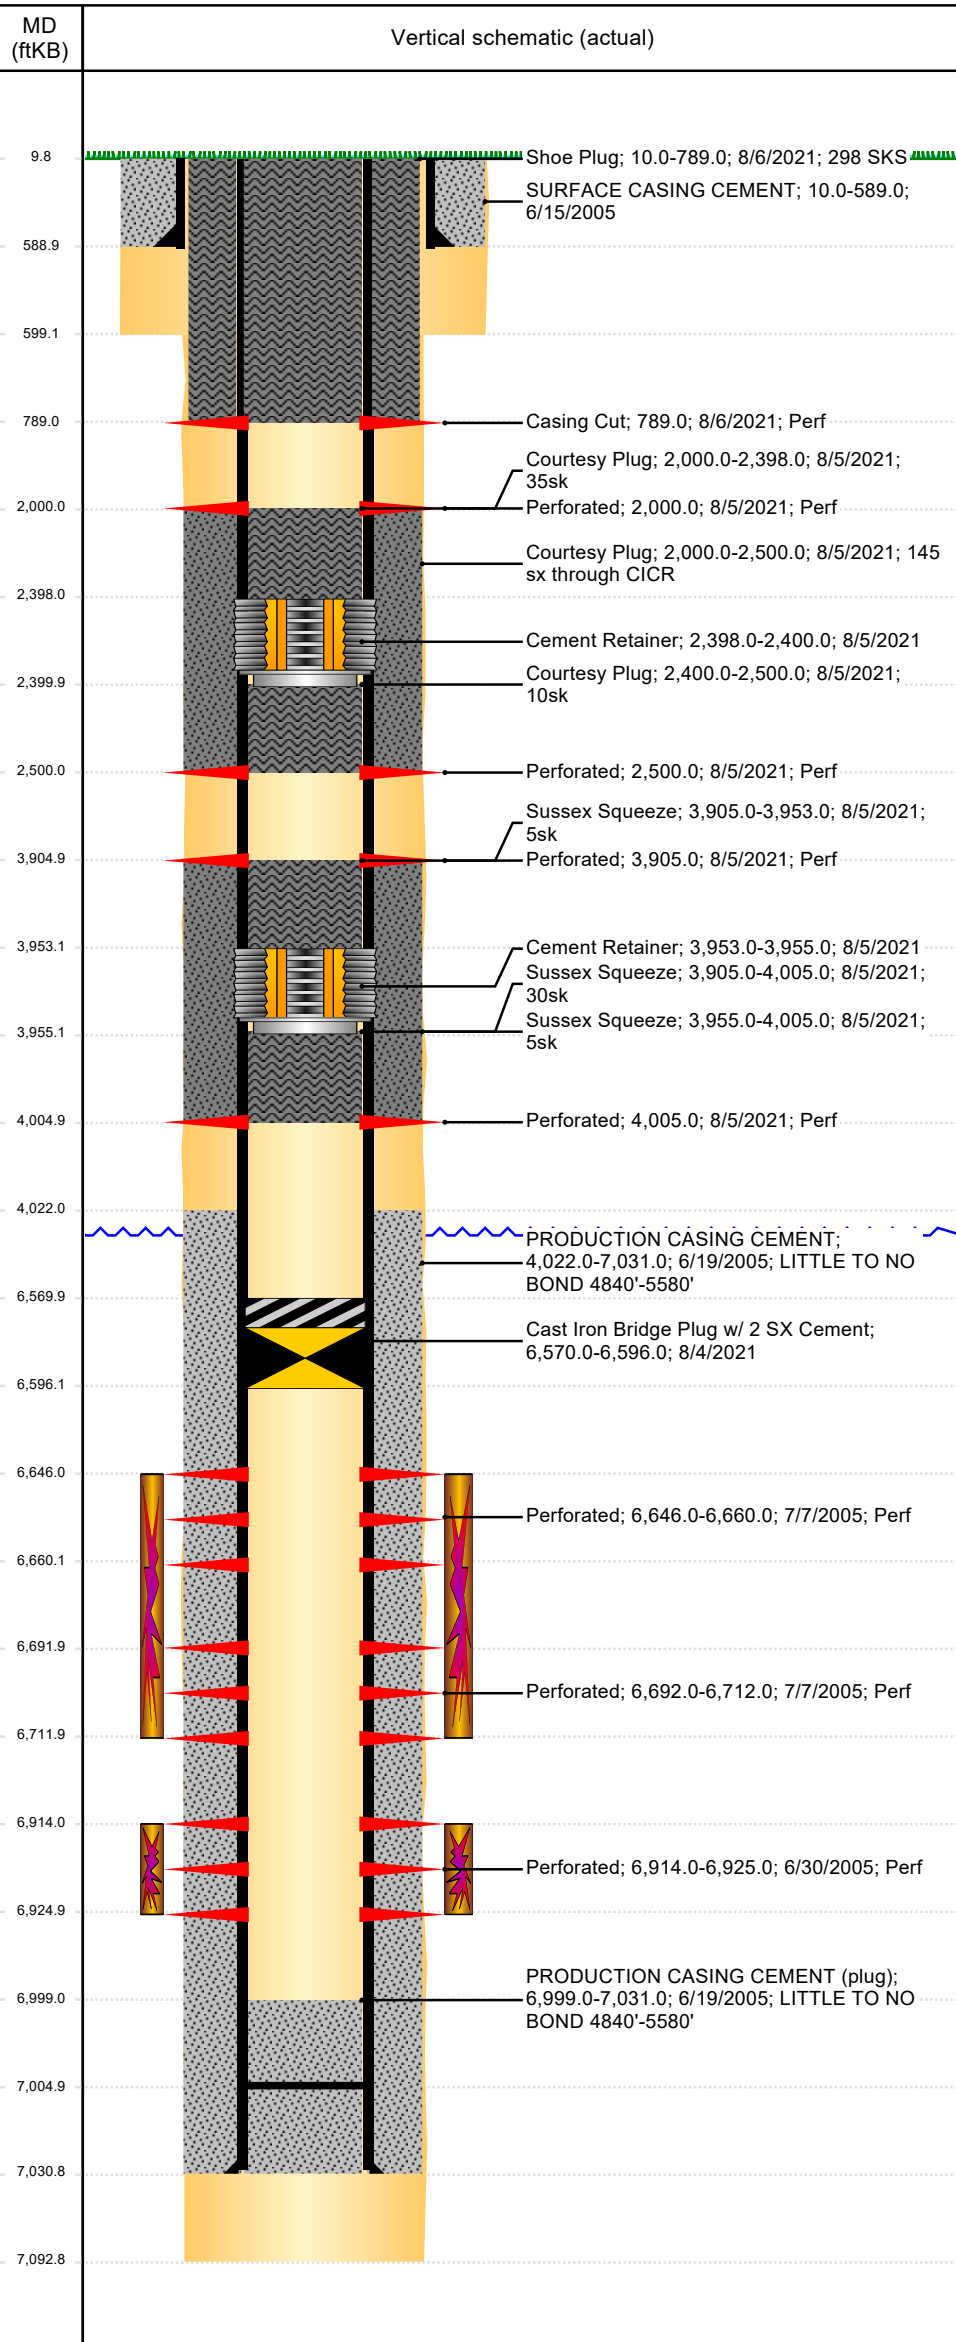

Well Header									
API 05-123-22933		Business Unit DJ BASIN			District 15		Well Configuration Type VERTICAL		
KB - GL / MSL (ftKB) 10.00		Spud Date 6/15/2005		P & A Date 9/29/2021		Well Production Status TA (AT SURFACE)			SoRT No
Comment CFP PUSHED TO 6948' 12/05									
Surface Location (Congressional)									
Quarter 3 SW	Quarter 4 SE	Section 4	Township 3	Twonshp N N	Range 64	Rng E/W W	Actual Latitude (°) 40.25073865		Actual Longitude (°) -104.55129130
Wellbore Sections									
Section Des			Size (in)			Act Top, MD (ftKB)		Act Btm, MD (ftKB)	
SURFACE			12 1/4			10		599	
PRODUCTION			7 7/8			599		7,093	
Casing Strings									
Csg Des			Run Date		OD (in)	Wt/Len (lb/ft)	Grade	Top, MD (ftKB)	MD (ftKB)
Surface Casing			6/15/2005		8 5/8	24.00		10.0	589.0
Production			6/19/2005		4 1/2	11.60	M-80	10.0	7,031.0
Cement									
Des					Start Date		Top (ftKB)		Btm (ftKB)
SURFACE CASING CEMENT					6/15/2005		10.0		589.0
PRODUCTION CASING CEMENT					6/19/2005		4,022.0		7,031.0
Sussex Squeeze					8/5/2021		3,905.0		4,005.0
Sussex Squeeze					8/5/2021		3,905.0		3,953.0
Sussex Squeeze					8/5/2021		3,955.0		4,005.0
Courtesy Plug					8/5/2021		2,000.0		2,500.0
Courtesy Plug					8/5/2021		2,000.0		2,398.0
Courtesy Plug					8/5/2021		2,400.0		2,500.0
Shoe Plug					8/6/2021		10.0		789.0
Zone Statuses									
Zone Name	Status Date	Status	Fluid Type	Job				Prod Method	
NIOBRARA	10/7/2016	SI							
NIOBRARA	8/4/2021	P&A		PLUG AND ABANDON, 8/4/2021 00:00					
CODELL	4/15/2010	PR		RE-FRAC, 3/10/2010 06:00					
CODELL	8/4/2021	P&A		PLUG AND ABANDON, 8/4/2021 00:00					
Perforation Data									
Linked Zone		Bnch/Stg	Entered Shot Total	Top (ftKB)		Btm (ftKB)		Date	
				789.00		789.00		8/6/2021	
				2,000.00		2,000.00		8/5/2021	
				2,500.00		2,500.00		8/5/2021	
				3,905.00		3,905.00		8/5/2021	
				4,005.00		4,005.00		8/5/2021	
NIOBRARA, ORIGINAL HOLE			84	6,646.00		6,660.00		7/7/2005	
NIOBRARA, ORIGINAL HOLE			120	6,692.00		6,712.00		7/7/2005	
CODELL, ORIGINAL HOLE			44	6,914.00		6,925.00		6/30/2005	
Stimulation Intervals									
Zone			Start Date			Top (ftKB)		Btm (ftKB)	
NIOBRARA, ORIGINAL HOLE			8/17/2007			6,646.0		6,712.0	
NIOBRARA, ORIGINAL HOLE			7/7/2005			6,646.0		6,712.0	
CODELL, ORIGINAL HOLE			7/7/2005			6,914.0		6,925.0	
CODELL, ORIGINAL HOLE			4/6/2010			6,914.0		6,925.0	
Other In Hole									
Run Date	Des				Make	OD (in)	Top (ftKB)	Btm (ftKB)	
8/4/2021	Cast Iron Bridge Plug w/ 2 SX Cement					4	6,570.0	6,596.0	
8/5/2021	Cement Retainer					4	3,953.0	3,955.0	
8/5/2021	Cement Retainer					4	2,398.0	2,400.0	
Logs									
Date		Type				Top, MD (ftKB)		Btm, MD (ftKB)	
6/19/2005		COMPENSATED DENSITY COMPENSATED NEUTRON				4,000.0		7,063.0	
6/19/2005		INDUCTION				589.0		7,083.0	
6/27/2005		CBL/CCL/GR				4,000.0		7,063.0	
6/18/2013		GYRO				0.0		6,850.0	

Well Name: MARIE D04-23

VERTICAL, ORIGINAL HOLE, 10/30/2021 9:31:06 AM

Plug Back Total Depths

