




P&A Wellbore For State

Well Name: ALOYSIUS 34-07

VERTICAL, ORIGINAL HOLE, 10/30/2021 10:49:22 AM

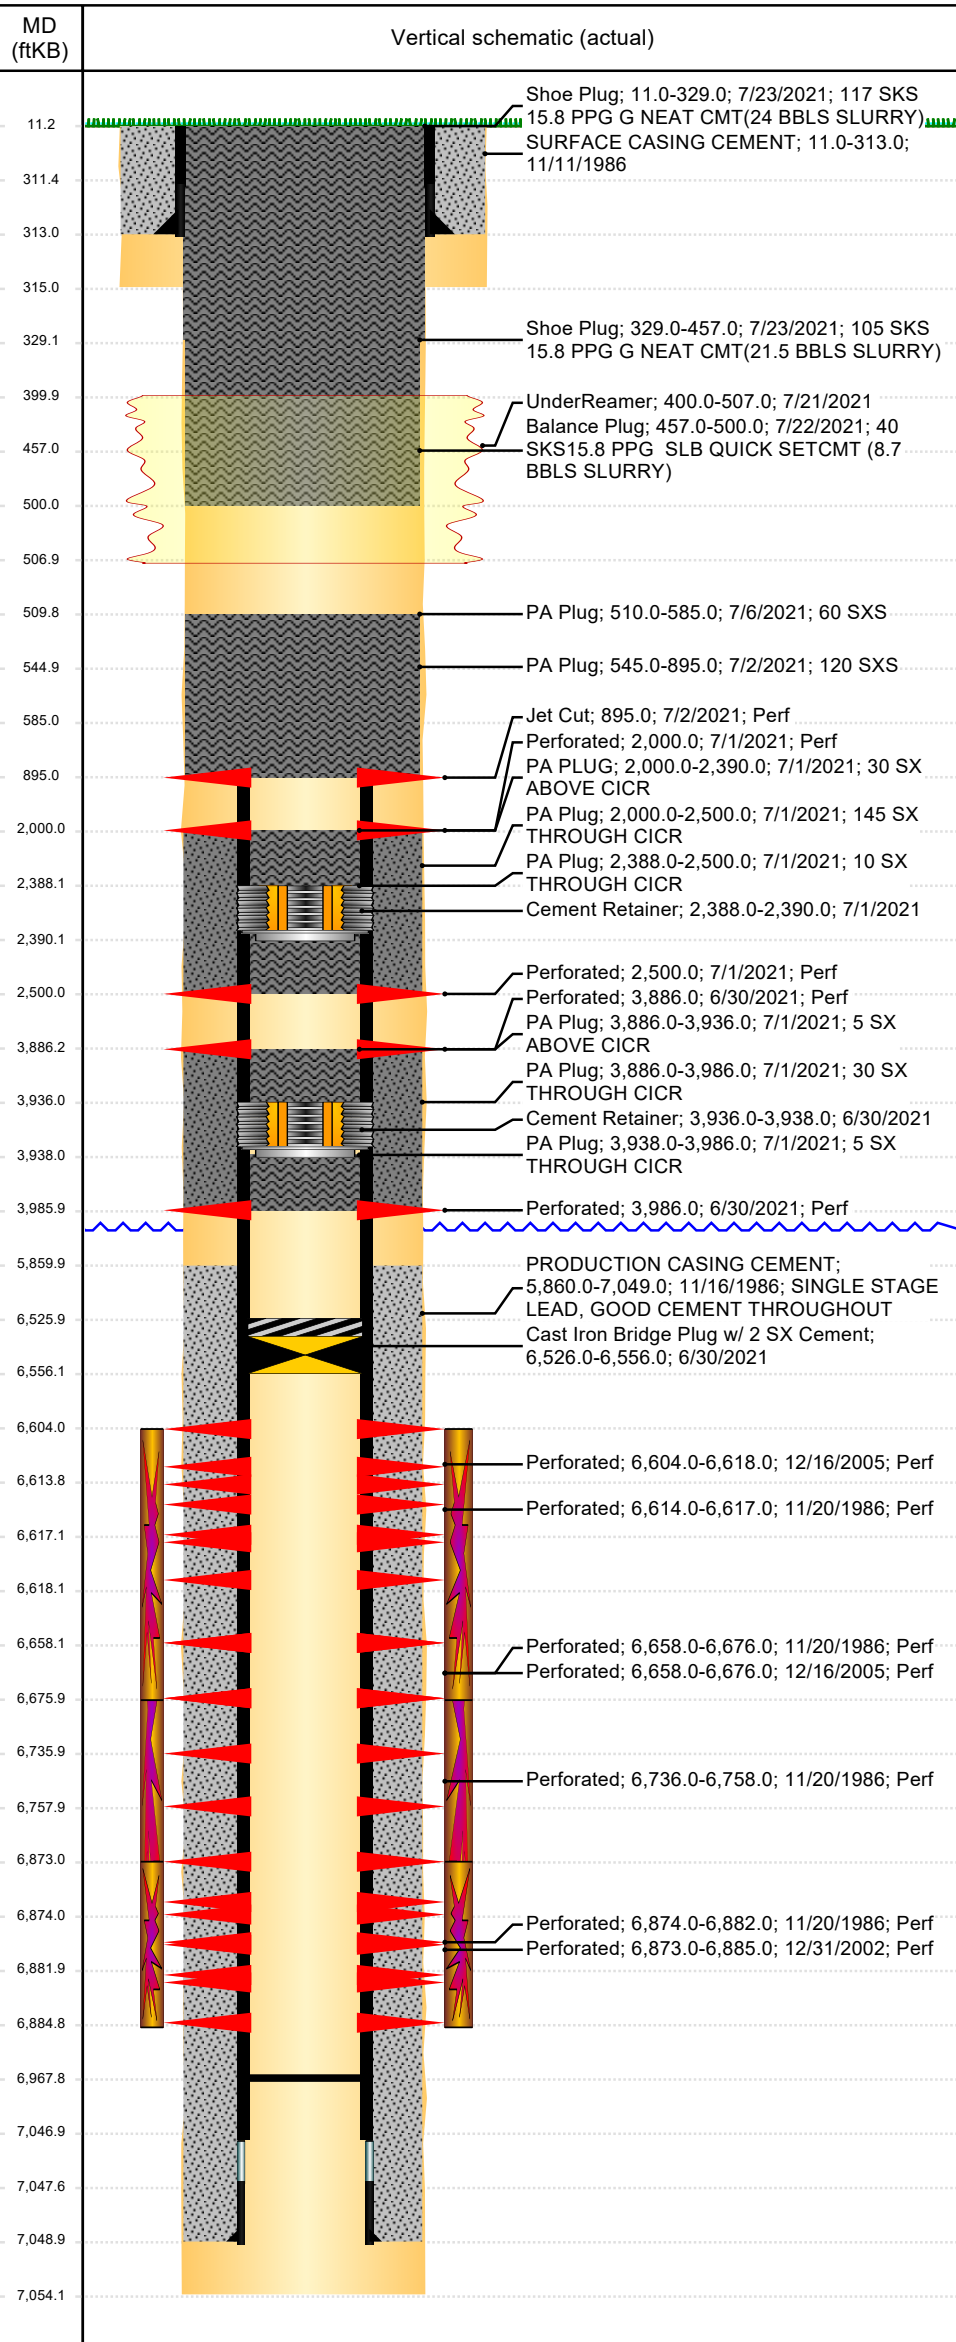

Well Header									
API 05-123-13238		Business Unit DJ BASIN			District 15		Well Configuration Type VERTICAL		
KB - GL / MSL (ftKB) 11.00		Spud Date 11/11/1986		P & A Date		Well Production Status PA			SoRT Yes
Comment LIMITED ENTRY DURING D/C. LIMITED D/C DATA IN FILE. DISCREPANCY IN FGS FOR D/C. ST HAS 1/14 AND 1/04. DISC. IN PROD CSG DEPTH. ST. HAS 7023 AND 7049. DISCREPANCY: DR RPT TD DATE 11/15/1986; ST RPT TD DATE 11/16/1986									
Surface Location (Congressional)									
Quarter 3 SW	Quarter 4 SW	Section 34	Township 4	Twnshp N N	Range 64	Rng E/W W	Actual Latitude (°) 40.26355134	Actual Longitude (°) -104.54416774	
Wellbore Sections									
Section Des			Size (in)			Act Top, MD (ftKB)		Act Btm, MD (ftKB)	
SURFACE			12 1/4			11		315	
PRODUCTION			7 7/8			315		7,054	
Casing Strings									
Csg Des			Run Date		OD (in)	Wt/Len (lb/ft)	Grade	Top, MD (ftKB)	MD (ftKB)
Surface			11/11/1986		8 5/8	24.00		11.0	313.0
Production			11/16/1986		4 1/2	15.10		11.0	7,049.0
Cement									
Des					Start Date		Top (ftKB)		Btm (ftKB)
SURFACE CASING CEMENT					11/11/1986		11.0		313.0
PRODUCTION CASING CEMENT					11/16/1986		5,860.0		7,049.0
PA Plug					7/1/2021		2,000.0		2,500.0
PA Plug					7/1/2021		3,886.0		3,936.0
PA Plug					7/1/2021		3,938.0		3,986.0
PA Plug					7/1/2021		3,886.0		3,986.0
PA PLUG					7/1/2021		2,000.0		2,390.0
PA Plug					7/1/2021		2,388.0		2,500.0
PA Plug					7/2/2021		545.0		895.0
PA Plug					7/6/2021		510.0		585.0
Balance Plug					7/22/2021		457.0		500.0
Shoe Plug					7/23/2021		329.0		457.0
Shoe Plug					7/23/2021		11.0		329.0
Zone Statuses									
Zone Name	Status Date	Status	Fluid Type	Job				Prod Method	
NIOBRARA	6/30/2021	TA		PLUG AND ABANDON, 6/30/2021 06:00					
NIOBRARA	7/23/2021	P&A		PLUG AND ABANDON, 6/30/2021 06:00					
NIOBRARA-CODELL	7/23/2021	P&A		PLUG AND ABANDON, 6/30/2021 06:00					
CODELL	6/30/2021	TA		PLUG AND ABANDON, 6/30/2021 06:00					
CODELL	7/23/2021	P&A		PLUG AND ABANDON, 6/30/2021 06:00					
Perforation Data									
Linked Zone		Bnch/Stg	Entered Shot Total	Top (ftKB)		Btm (ftKB)		Date	
				895.00		895.00		7/2/2021	
			6	2,000.00		2,000.00		7/1/2021	
			6	2,500.00		2,500.00		7/1/2021	
			6	3,886.00		3,886.00		6/30/2021	
			6	3,986.00		3,986.00		6/30/2021	
NIOBRARA, ORIGINAL HOLE			84	6,604.00		6,618.00		12/16/2005	
NIOBRARA, ORIGINAL HOLE		A	2	6,614.00		6,617.00		11/20/1986	
NIOBRARA, ORIGINAL HOLE		B	5	6,658.00		6,676.00		11/20/1986	
NIOBRARA, ORIGINAL HOLE			108	6,658.00		6,676.00		12/16/2005	
NIOBRARA, ORIGINAL HOLE		C	3	6,736.00		6,758.00		11/20/1986	
CODELL, ORIGINAL HOLE			48	6,873.00		6,885.00		12/31/2002	
CODELL, ORIGINAL HOLE			5	6,874.00		6,882.00		11/20/1986	
Stimulation Intervals									
Zone				Start Date		Top (ftKB)		Btm (ftKB)	
NIOBRARA, ORIGINAL HOLE				1/5/2006		6,604.0		6,676.0	
NIOBRARA-CODELL, ORIGINAL HOLE				11/21/1986		6,614.0		6,882.0	
CODELL, ORIGINAL HOLE				1/3/2003		6,873.0		6,885.0	
Other In Hole									
Run Date		Des			Make		OD (in)	Top (ftKB)	Btm (ftKB)
6/30/2021		Cast Iron Bridge Plug w/ 2 SX Cement					3.83	6,526.0	6,556.0

Well Name: ALOYSIUS 34-07

VERTICAL, ORIGINAL HOLE, 10/30/2021 10:49:22 AM

Other In Hole

Run Date	Des	Make	OD (in)	Top (ftKB)	Btm (ftKB)
6/30/2021	Cement Retainer		3.83	3,936.0	3,938.0
7/1/2021	Cement Retainer		3.83	2,388.0	2,390.0
7/21/2021	UnderReamer		12	400.0	507.0

Logs

Date	Type	Top, MD (ftKB)	Btm, MD (ftKB)
11/15/1986	COMPENSATED DENSITY	313.0	7,034.0
11/15/1986	COMPUTER ANALYZED LOG	3,600.0	7,000.0
11/15/1986	INDUCTION	3,600.0	7,000.0
11/19/1986	CEMENT BOND	5,875.0	6,966.0
12/9/2010	GYRO	10.0	6,860.0

Plug Back Total Depths

Date	Type	Com	Depth (ftKB)
11/19/1986	FILL	DEPTH LOGGER ON CBL	6,971.0
1/21/2006	FILL	TAG TO LAND TUBING	6,968.0

