


Well Name: MARIE D04-13

VERTICAL, ORIGINAL HOLE, 10/31/2021 9:00:12 AM

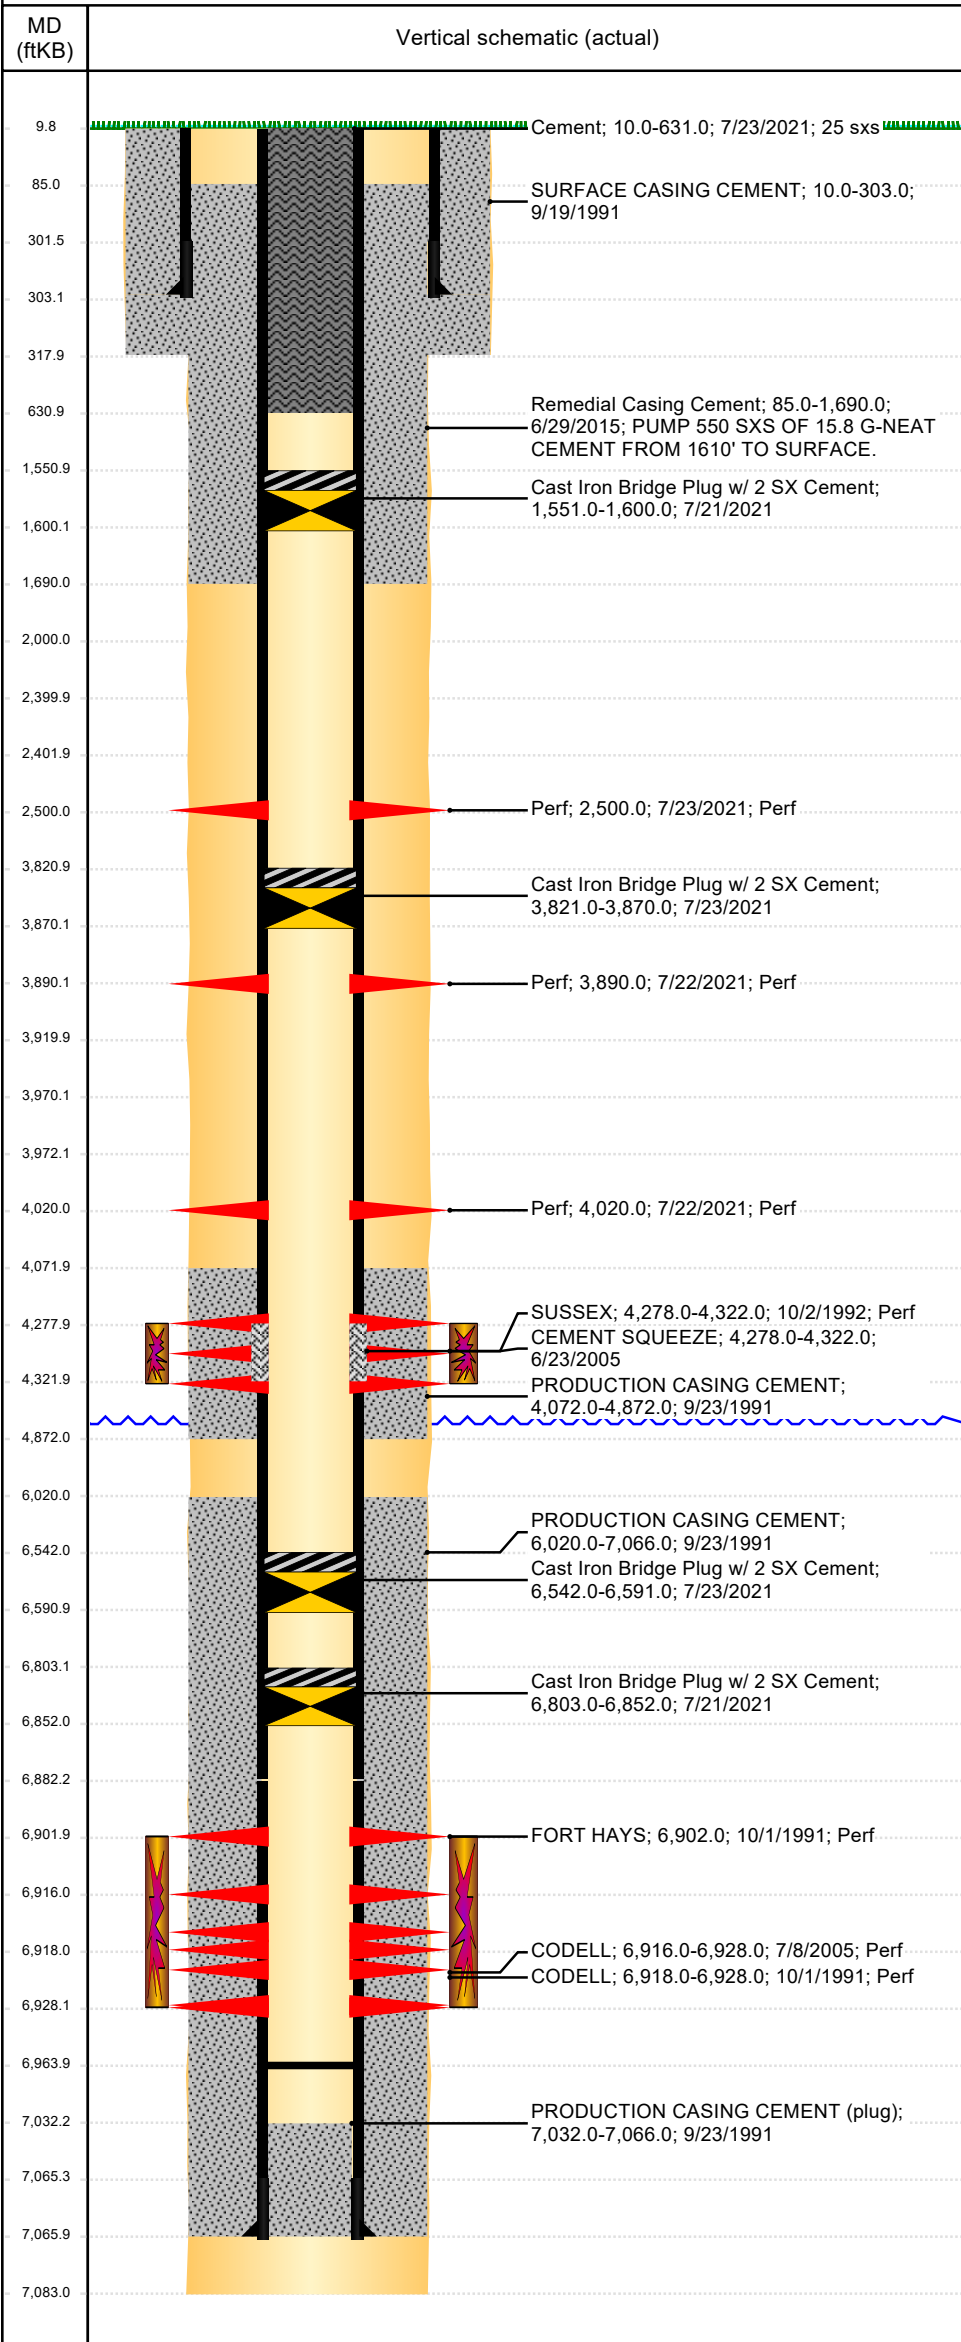

Well Header									
API 05-123-15142		Business Unit DJ BASIN			District 15		Well Configuration Type VERTICAL		
KB - GL / MSL (ftKB) 10.00		Spud Date 9/19/1991		P & A Date 8/23/2021		Well Production Status PA			SoRT Yes
Comment									
Surface Location (Congressional)									
Quarter 3 SW	Quarter 4 SW	Section 4	Township 3	Twnshp N N	Range 64	Rng E/W W	Actual Latitude (°) 40.24901605	Actual Longitude (°) -104.56240000	
Wellbore Sections									
Section Des			Size (in)			Act Top, MD (ftKB)		Act Btm, MD (ftKB)	
SURFACE			12 1/4			10		318	
PRODUCTION			7 7/8			318		7,083	
Casing Strings									
Csg Des			Run Date		OD (in)	Wt/Len (lb/ft)	Grade	Top, MD (ftKB)	MD (ftKB)
Surface			9/19/1991		8 5/8	24.00	J-55	10.0	303.0
Production			9/23/1991		3 1/2	10.30	N-80	10.0	7,066.0
Cement									
Des					Start Date		Top (ftKB)		Btm (ftKB)
SURFACE CASING CEMENT					9/19/1991		10.0		303.0
PRODUCTION CASING CEMENT					9/23/1991		4,072.0		4,872.0
PRODUCTION CASING CEMENT					9/23/1991		6,020.0		7,066.0
CEMENT SQUEEZE					6/23/2005		4,278.0		4,322.0
Remedial Casing Cement					6/29/2015		85.0		1,690.0
					7/23/2021		10.0		631.0
Zone Statuses									
Zone Name	Status Date	Status	Fluid Type	Job				Prod Method	
CODELL	9/21/2017	PR	Gas	PLUG AND ABANDON, 7/21/2021 00:00					
CODELL	7/21/2021	P&A		RE-FRAC, 6/21/2005 00:00					
SUSSEX	6/23/2005	AB		PLUG AND ABANDON, 7/21/2021 00:00					
SUSSEX	7/21/2021	P&A		PLUG AND ABANDON, 7/21/2021 00:00					
FORT HAYS	7/21/2021	P&A		PLUG AND ABANDON, 7/21/2021 00:00					
FORT HAYS	7/21/2021	P&A							
CODELL-FORT HA'	7/21/2021	P&A							
CODELL-FORT HA'	7/21/2021	P&A	PLUG AND ABANDON, 7/21/2021 00:00						
Perforation Data									
Linked Zone		Bnch/Stg	Entered Shot Total	Top (ftKB)		Btm (ftKB)		Date	
SUSSEX, ORIGINAL HOLE FORT HAYS, ORIGINAL HOLE CODELL, ORIGINAL HOLE CODELL, ORIGINAL HOLE			60 2 48 40	2,500.00		2,500.00		7/23/2021	
				3,890.00		3,890.00		7/22/2021	
				4,020.00		4,020.00		7/22/2021	
				4,278.00		4,322.00		10/2/1992	
				6,902.00		6,902.00		10/1/1991	
				6,916.00		6,928.00		7/8/2005	
				6,918.00		6,928.00		10/1/1991	
Stimulation Intervals									
Zone			Start Date		Top (ftKB)		Btm (ftKB)		
SUSSEX, ORIGINAL HOLE			10/1/1992		4,278.0		4,322.0		
CODELL-FORT HAYS, ORIGINAL HOLE			10/8/1991		6,902.0		6,928.0		
CODELL-FORT HAYS, ORIGINAL HOLE			7/15/2005		6,902.0		6,928.0		
Other In Hole									
Run Date	Des				Make	OD (in)	Top (ftKB)	Btm (ftKB)	
7/21/2021	Cast Iron Bridge Plug w/ 2 SX Cement					3	1,551.0	1,600.0	
7/21/2021	Cast Iron Bridge Plug w/ 2 SX Cement					3	6,803.0	6,852.0	
7/23/2021	Cast Iron Bridge Plug w/ 2 SX Cement					3	6,542.0	6,591.0	
7/23/2021	Cast Iron Bridge Plug w/ 2 SX Cement					3	3,821.0	3,870.0	
Logs									
Date		Type				Top, MD (ftKB)		Btm, MD (ftKB)	
9/23/1991		COMPENSATED DENSITY				3,900.0		7,049.0	
9/23/1991		INDUCTION				4,100.0		4,800.0	
9/23/1991		MICROLOG				3,900.0		4,800.0	
10/1/1991		CBL/CCL/GR				3,950.0		7,028.0	
6/30/2015		CBL/CCL/GR				10.0		2,000.0	
6/2/2020		GYRO				100.0		6,800.0	



P&A Wellbore For State

Well Name: MARIE D04-13

