


Well Name: ALE H FEDERAL 04-02JI

VERTICAL, ORIGINAL HOLE, 11/13/2021 9:46:16 AM

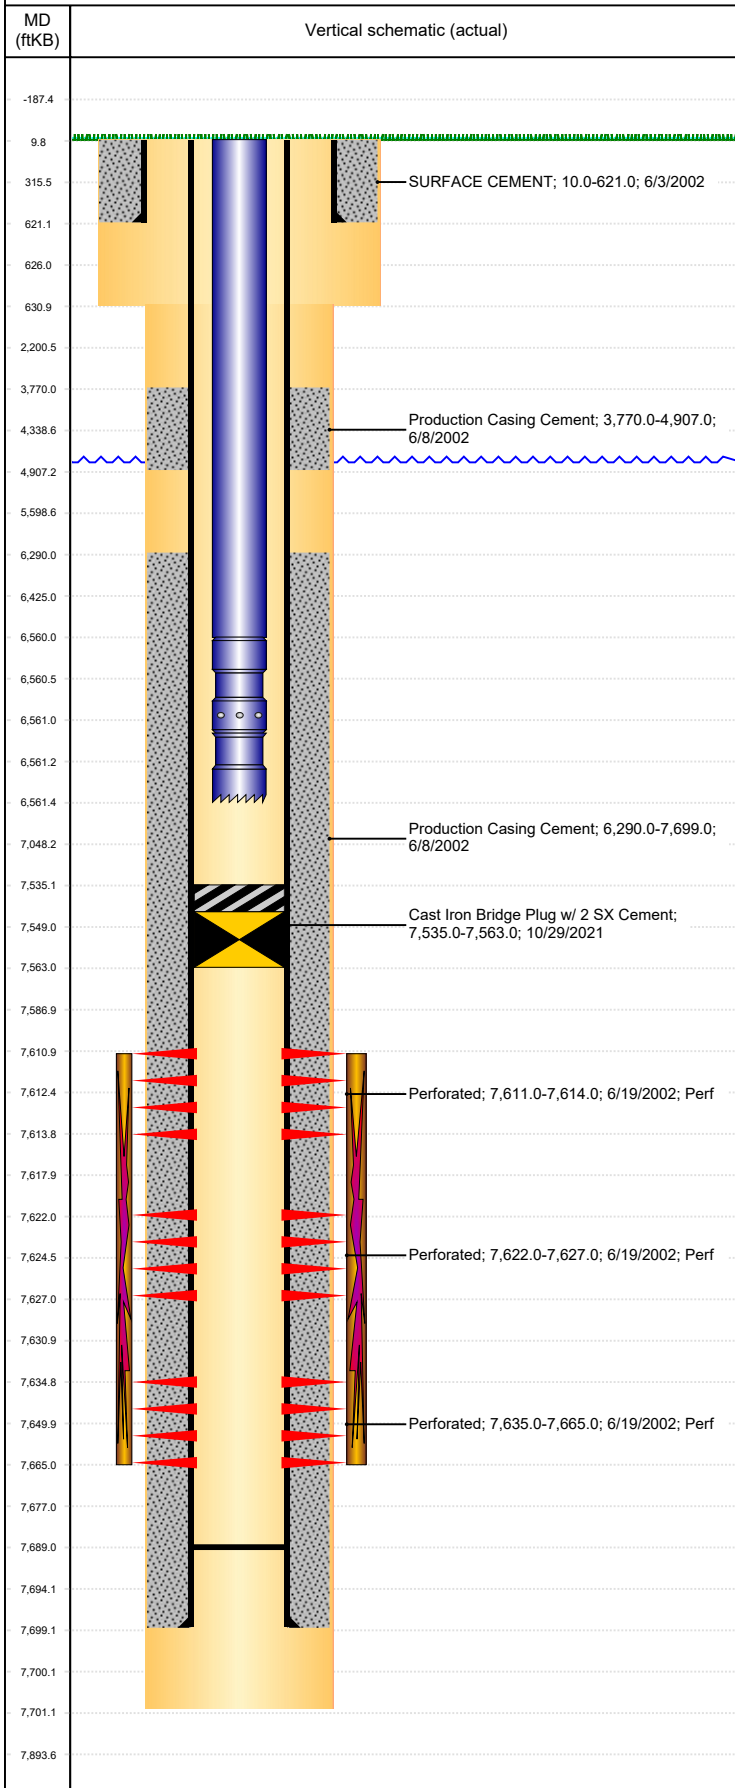

Well Header										
API 05-123-20939		Business Unit DJ BASIN			District 15		Well Config VERTICAL			
KB - GL / MSL (ft... 10.00		Spud Date 6/3/2002		P & A Date		Well Production Status TA		SoRT Yes		
Comment DV tool @ 4887										
Surface Location (Congressional)										
Qtr 3 NW	Qtr 4 NE	Section 4	Twtnshp 3	Twtnsh... N	Range 65	Rng E/... W	Actual Latitude (°) 40.25957173	Actual Longitude (°) -104.66549298		
Wellbore Sections										
Section Des			Size (in)			Act Top, MD (ftKB)		Act Btm, MD (ftKB)		
SURFACE			12 1/4			10		631		
PRODUCTION			7 7/8			631		7,701		
Casing Strings										
Csg Des			Run Date		OD (in)	Wt/Len (lb/ft)	Grade	Top, MD (ftKB)	MD (ftKB)	
Surface Casing			6/4/2002		8 5/8	24.00		10.0	621.0	
Production			6/8/2002		4 1/2	11.60	N-80	10.0	7,699.0	
Cement										
Des					Start Date		Top (ftKB)		Btm (ftKB)	
SURFACE CEMENT					6/3/2002		10.0		621.0	
Production Casing Cement					6/8/2002		3,770.0		4,907.0	
Production Casing Cement					6/8/2002		6,290.0		7,699.0	
Zone Statuses										
Zone Name		Status Date		Status	Fluid Type		Job		Prod Method	
J SAND		6/16/2009		PR	Water				Flowing	
J SAND		10/29/2021		TA	Water					
Perforation Data										
Linked Zone			Bnch/Stg	Entered Shot Total		Top (ftKB)		Btm (ftKB)		Date
J SAND, ORIGINAL HOLE				6		7,611.00		7,614.00		6/19/2002
J SAND, ORIGINAL HOLE				10		7,622.00		7,627.00		6/19/2002
J SAND, ORIGINAL HOLE				60		7,635.00		7,665.00		6/19/2002
Stimulation Intervals										
Zone					Start Date		Top (ftKB)		Btm (ftKB)	
J SAND, ORIGINAL HOLE					6/28/2002		7,611.0		7,665.0	
Other In Hole										
Run Date		Des			Make		OD (in)	Top (ftKB)	Btm (ftKB)	
10/29/2021		Cast Iron Bridge Plug w/ 2 SX Cement					3.99	7,535.0	7,563.0	
Logs										
Date		Type					Top, MD (ftKB)		Btm, MD (ftKB)	
6/8/2002		COMPENSATED DENSITY					4,300.0		7,675.0	
6/8/2002		INDUCTION					621.0		7,795.0	
6/19/2002		CBL/CCL/GR					3,540.0		7,673.0	
Plug Back Total Depths										
Date		Type			Com				Depth (ftKB)	
6/8/2002		FLOAT COLLAR							7,689.0	
12/12/2008		FILL			BAILED DOWN				7,689.0	