




DRILLING COMPANY, INC.
WICHITA, KANSAS

WELLBORE DIAGRAM

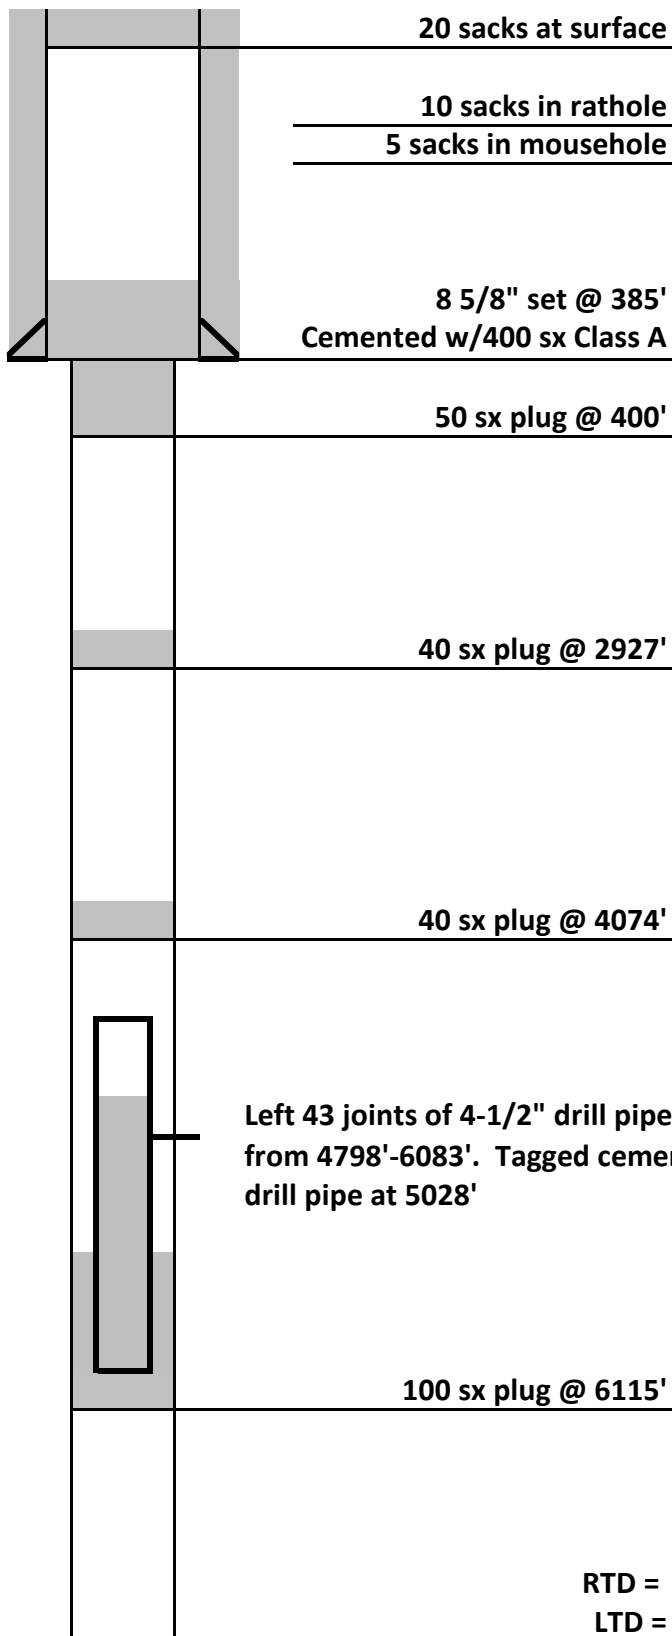

Date: 11/3/2021

Well Name: BSR "A" #19

Location: 1364' FSL & 2481' FWL
SE/4 NW/4 19-12S-53W

County: Lincoln

State: Colorado

API: 05-073-06779-00


Cemented with: 400 sx Class A

Total Depth: 6950'

Spud Date: 9/26/2021

P&A Date: 10/19/2021

LOG TOPS	
FORMATION	DEPTH
Niobrara	2000
Dakota D	3019
Lyons	4285
Shawnee	5429
Lansing	5679
Marmaton	6061
Cherokee	6167
Morrow	6763
Keyes	6914
Mississippian	6947
RTD	6950
LTD	6950