


Actual WBD (12/1/21)

Tyler Rockies Exploration, Ltd.

Linnebur #1-6

1839' FNL & 2120' FEL (SWNE) Sec 6-T4S-R59W, 6<sup>th</sup> P.M.

Arapahoe County, Colorado

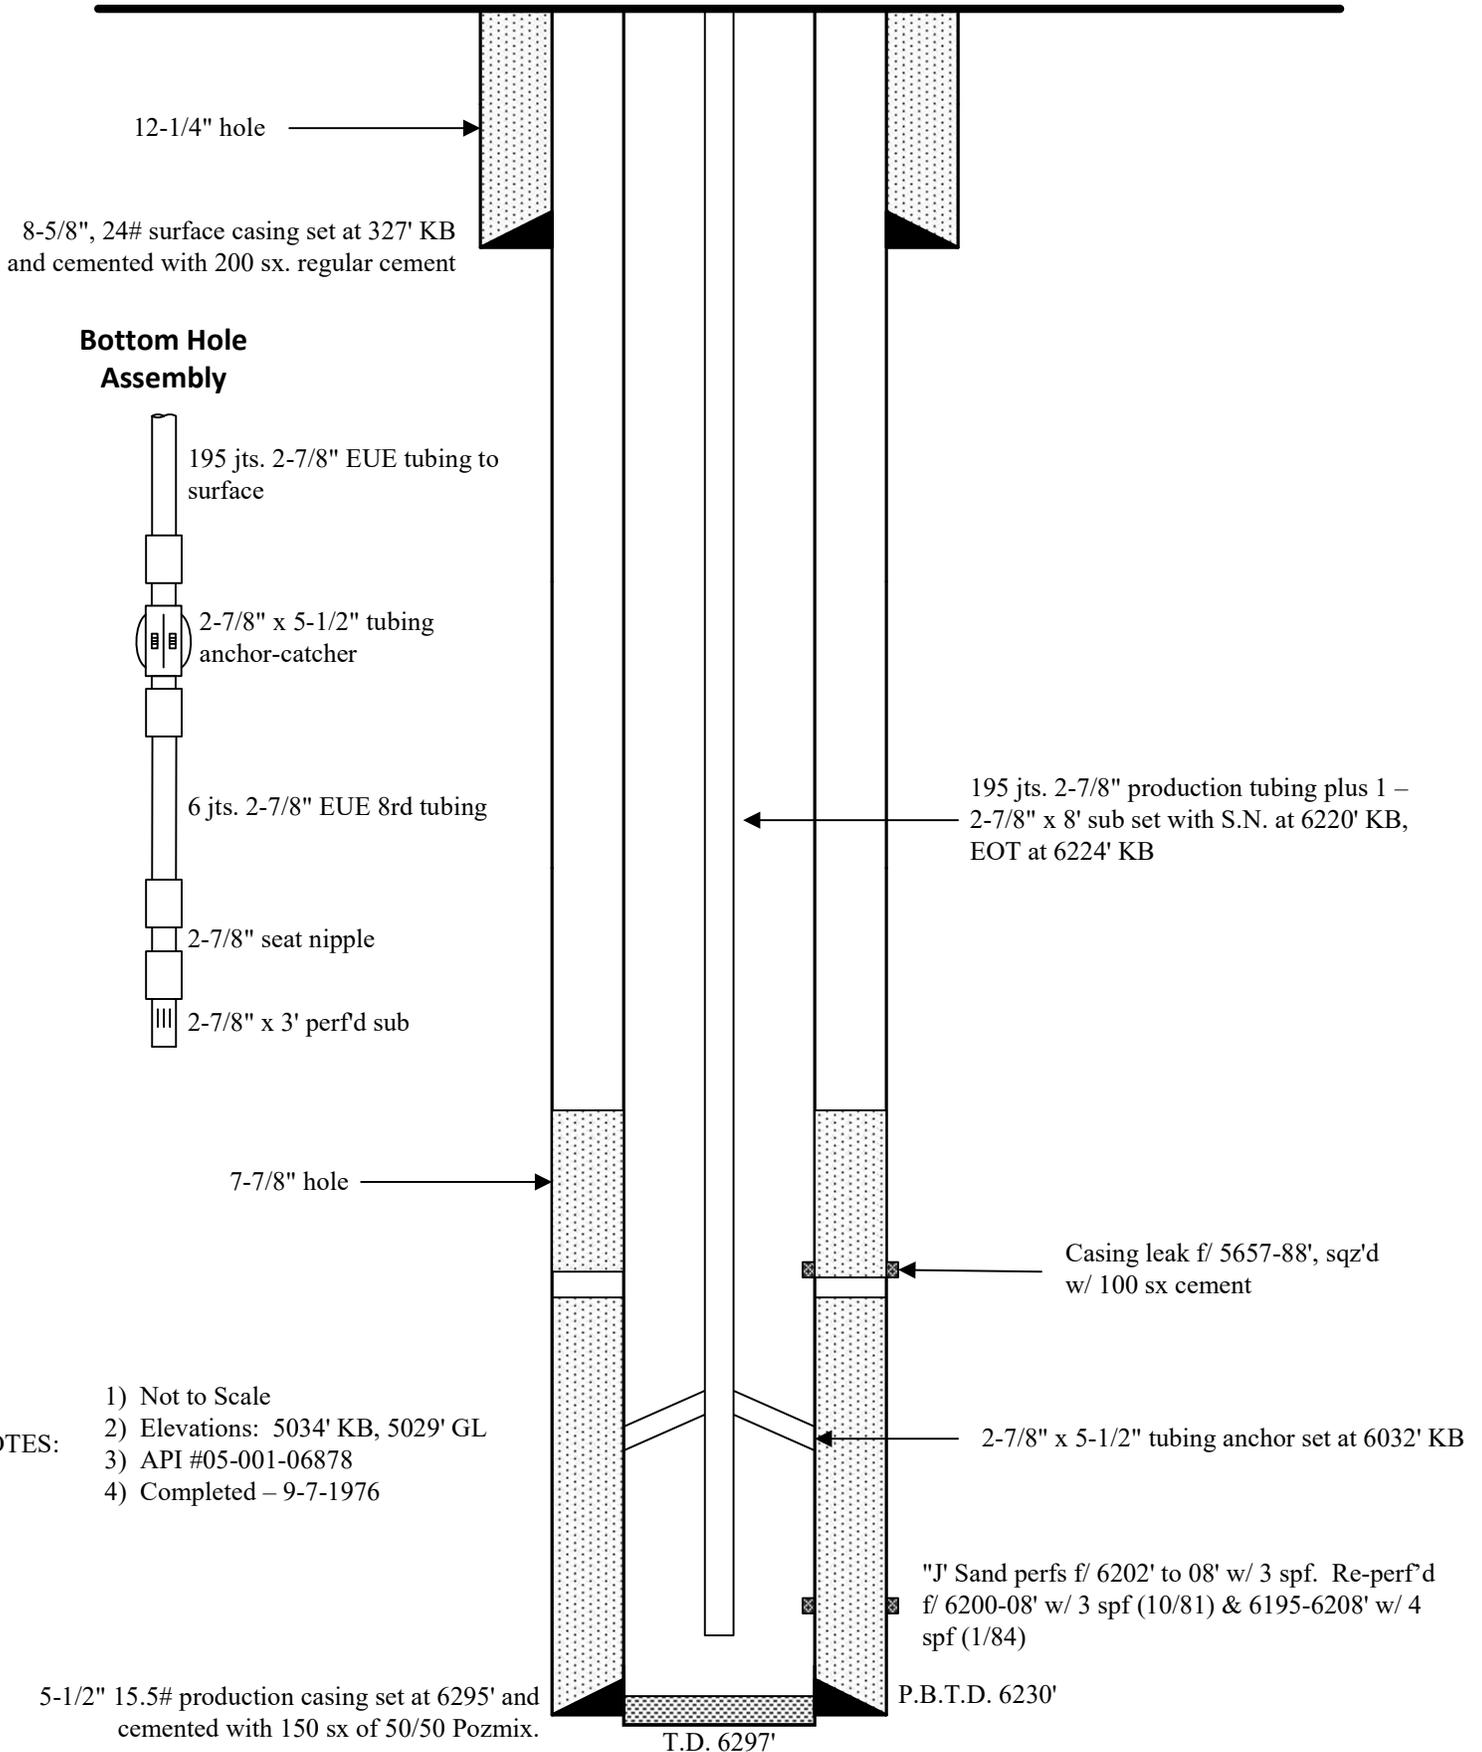

- NOTES:
- 1) Not to Scale
  - 2) Elevations: 5034' KB, 5029' GL
  - 3) API #05-001-06878
  - 4) Completed - 9-7-1976