


Actual WBD (12/1/21)

Tyler Rockies Exploration, Ltd.

Linnebur #2-R

2173' FSL & 2114' FEL (NWSE) Sec 31-T3S-R59W, 6<sup>th</sup> P.M.

Adams County, Colorado

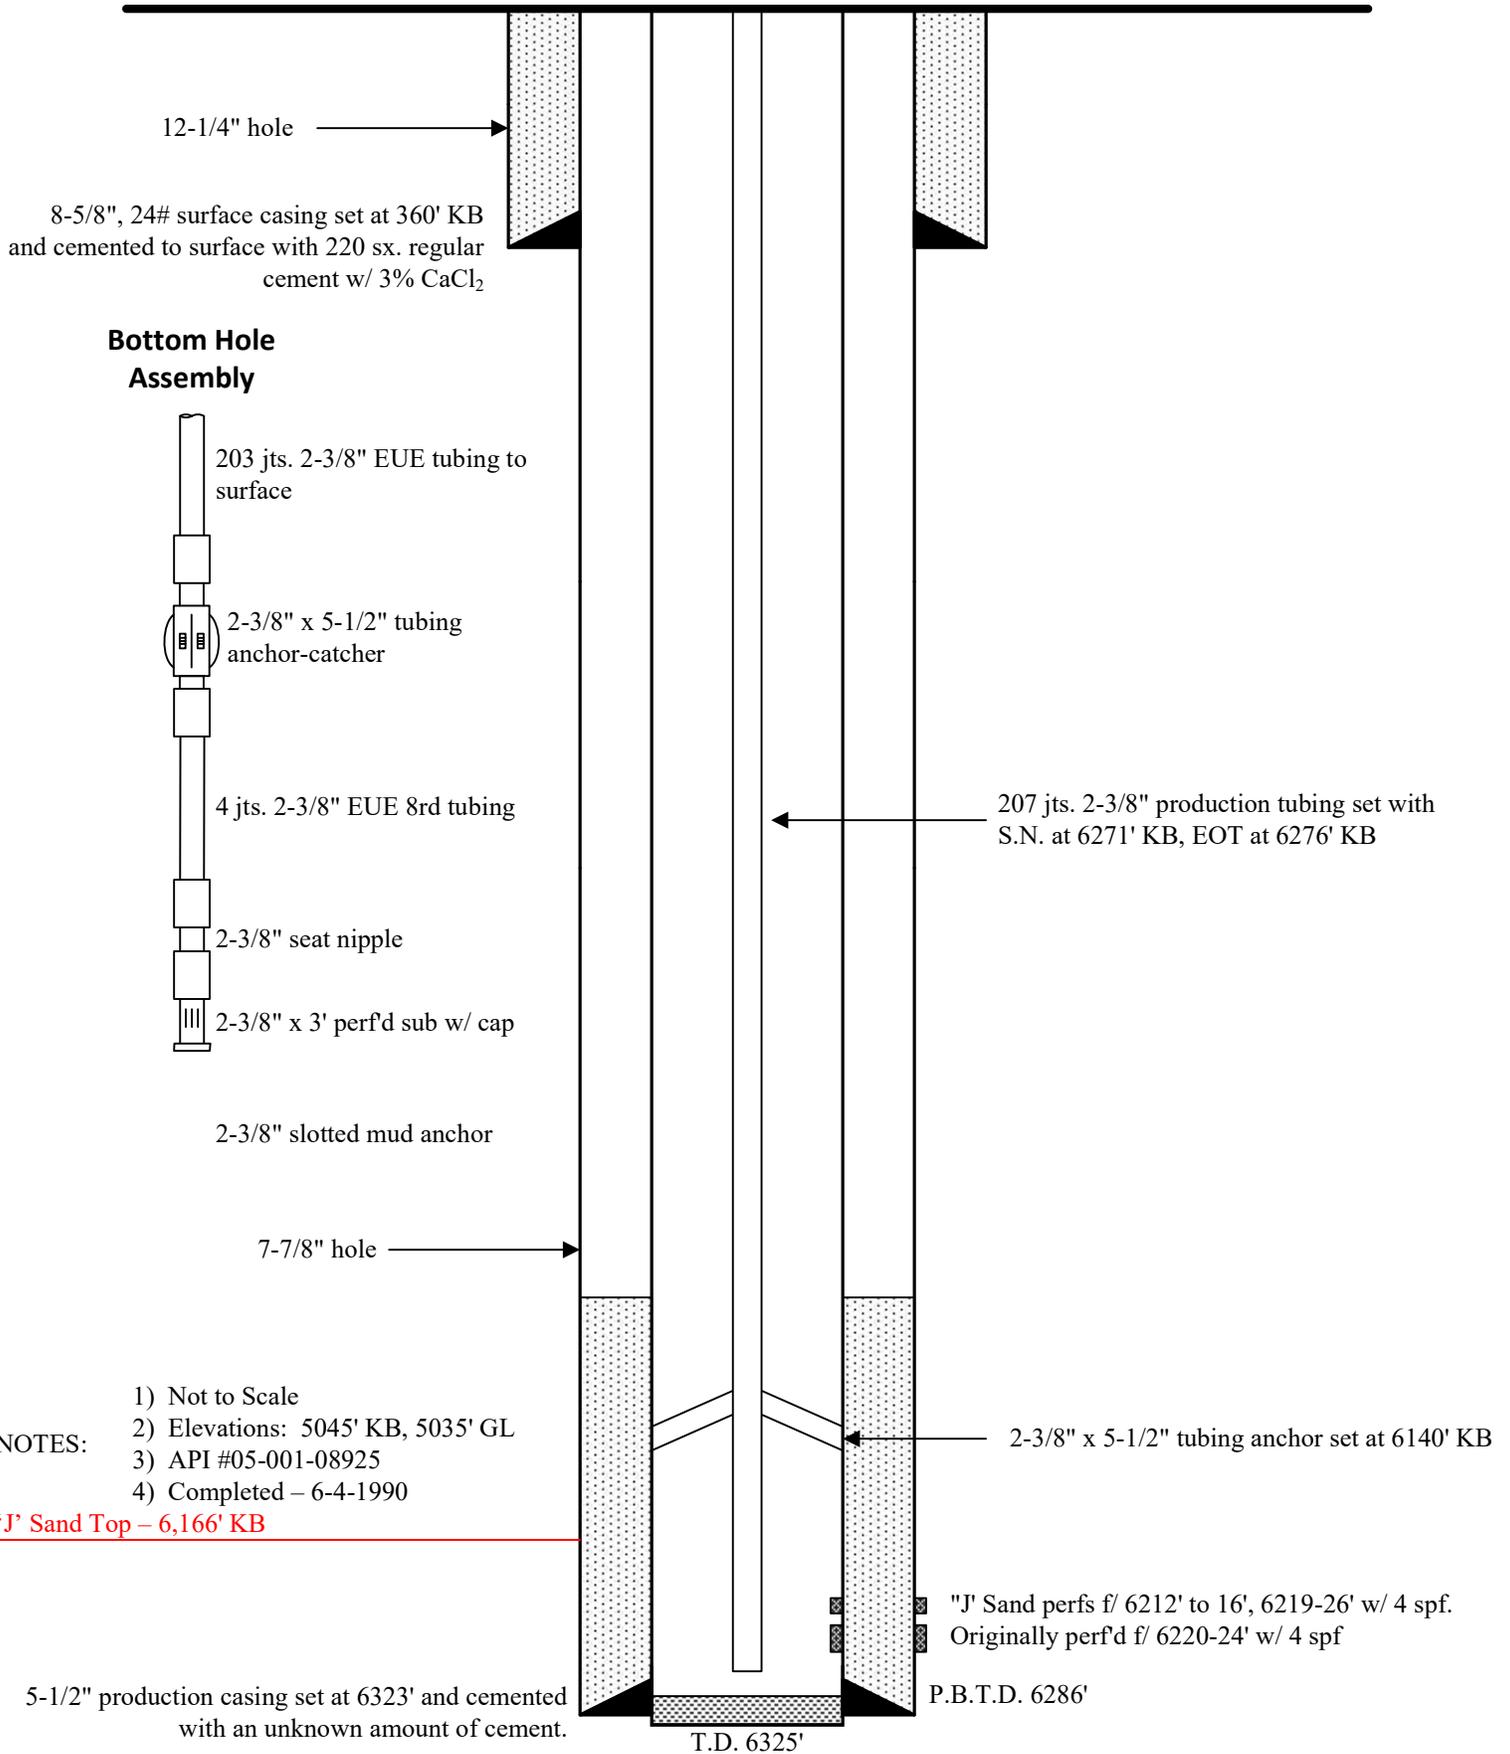

- NOTES:
- 1) Not to Scale
  - 2) Elevations: 5045' KB, 5035' GL
  - 3) API #05-001-08925
  - 4) Completed - 6-4-1990

'J' Sand Top - 6,166' KB

5-1/2" production casing set at 6323' and cemented with an unknown amount of cement.

T.D. 6325'

P.B.T.D. 6286'