

SAMPLE KEY	
EQUIPMENT TYPE	ACRONYM
Oil Tank	AST
Vessel	PWV
Dump Line	WDL
Separator Flowline(s)	SEP-FL
Separator Dump Line(s)	SEP-DL
3rd Party Meter House	MH

DATE:	September 7, 2021
DESIGNED BY:	C. Hamlin
DRAWN BY:	D. Brightwell



**TASMAN**  
GEOSCIENCES


**Tasman Geosciences, Inc.**  
6855 W. 119<sup>th</sup> Ave.  
Broomfield, CO 80020

**PDC Energy, Inc. – DJ Basin**  
**Former Buffalo Gardens 41-13 Tank Battery**  
NENE, Section 13, Township 2 North, Range 68 West  
Weld County, Colorado

**SOIL SAMPLE  
LOCATION MAP**

**FIGURE  
1**



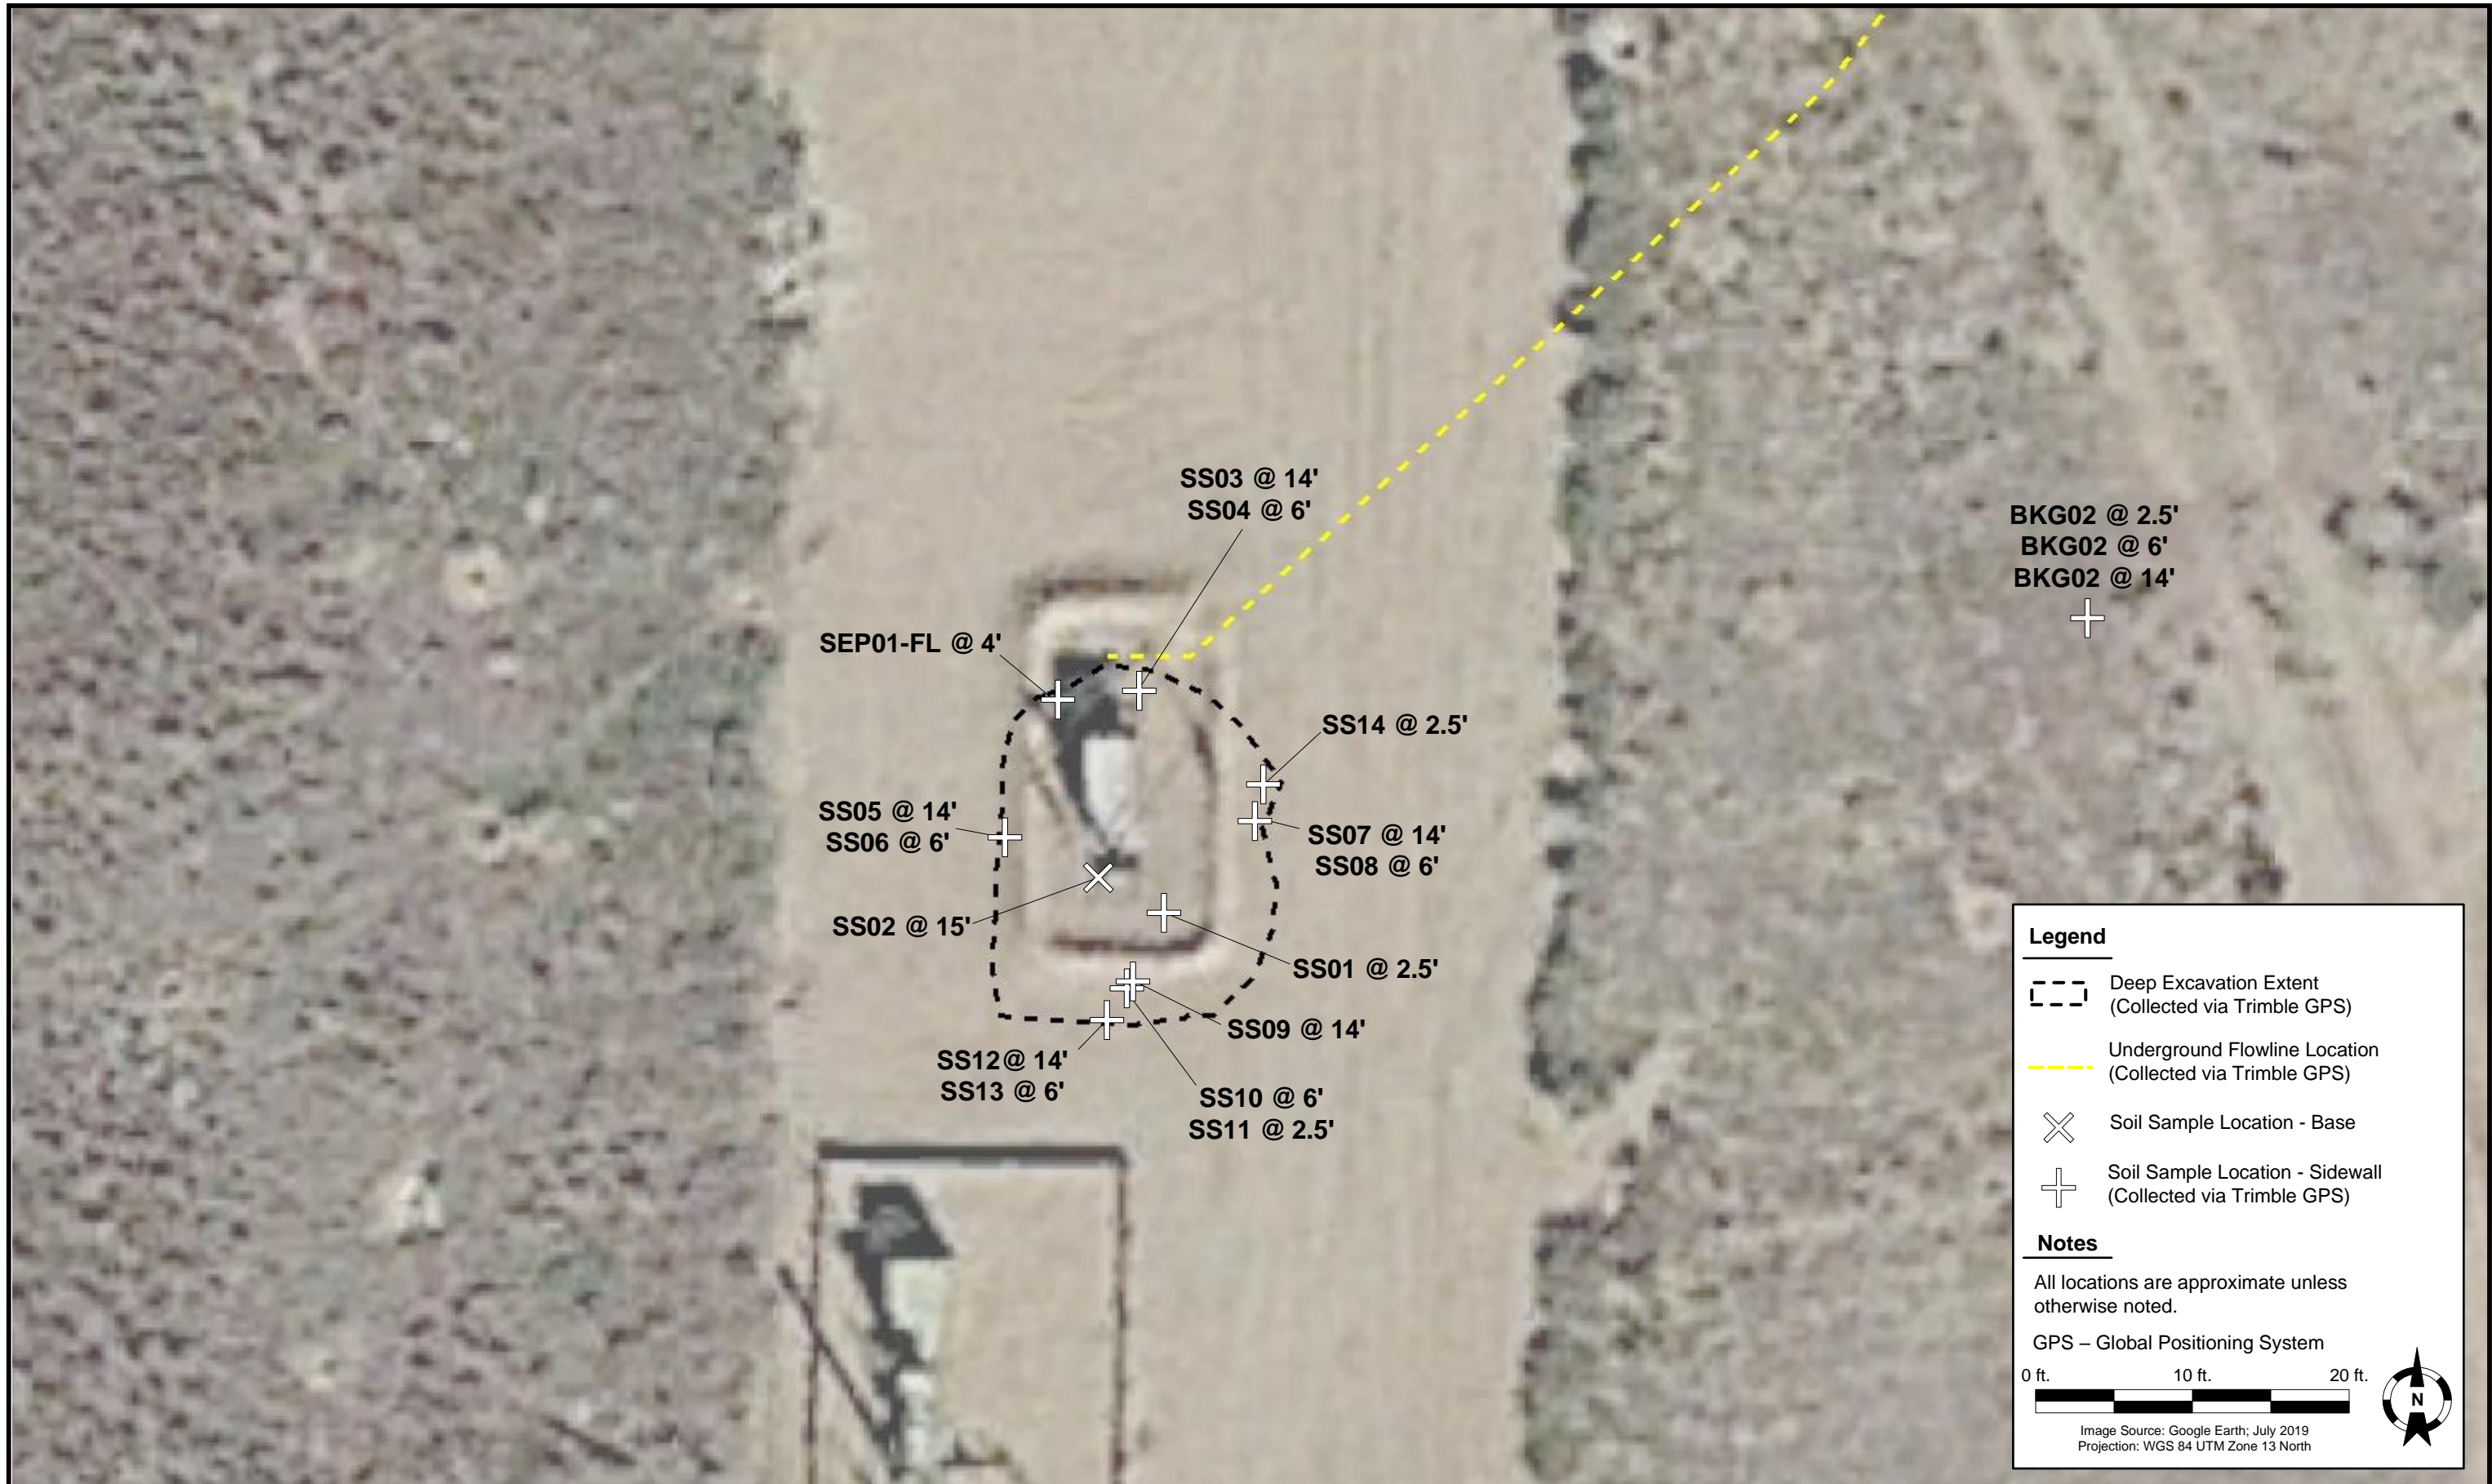





**Legend**

- Deep Excavation Extent  
(Collected via Trimble GPS)
- Underground Flowline Location  
(Collected via Trimble GPS)
- Proposed Soil Boring Location

**Notes**

All locations are approximate unless otherwise noted.

GPS – Global Positioning System

0 ft. 10 ft. 20 ft.



Image Source: Google Earth; July 2019  
Projection: WGS 84 UTM Zone 13 North



DATE:	November 22, 2021
DESIGNED BY:	C. Hamlin
DRAWN BY:	B. Goldade



**TASMAN**  
GEOSCIENCES

**Tasman Geosciences, Inc.**  
6855 W. 119<sup>th</sup> Ave.  
Broomfield, CO 80020

**PDC Energy, Inc. – DJ Basin**  
**Former Buffalo Gardens 41-13 Tank Battery**  
NENE, Section 13, Township 2 North, Range 68 West  
Weld County, Colorado

**PROPOSED SOIL BORING  
LOCATION MAP**

**FIGURE  
3**