


Colorado National Bank #1 Subsequent Wellbore Diagram

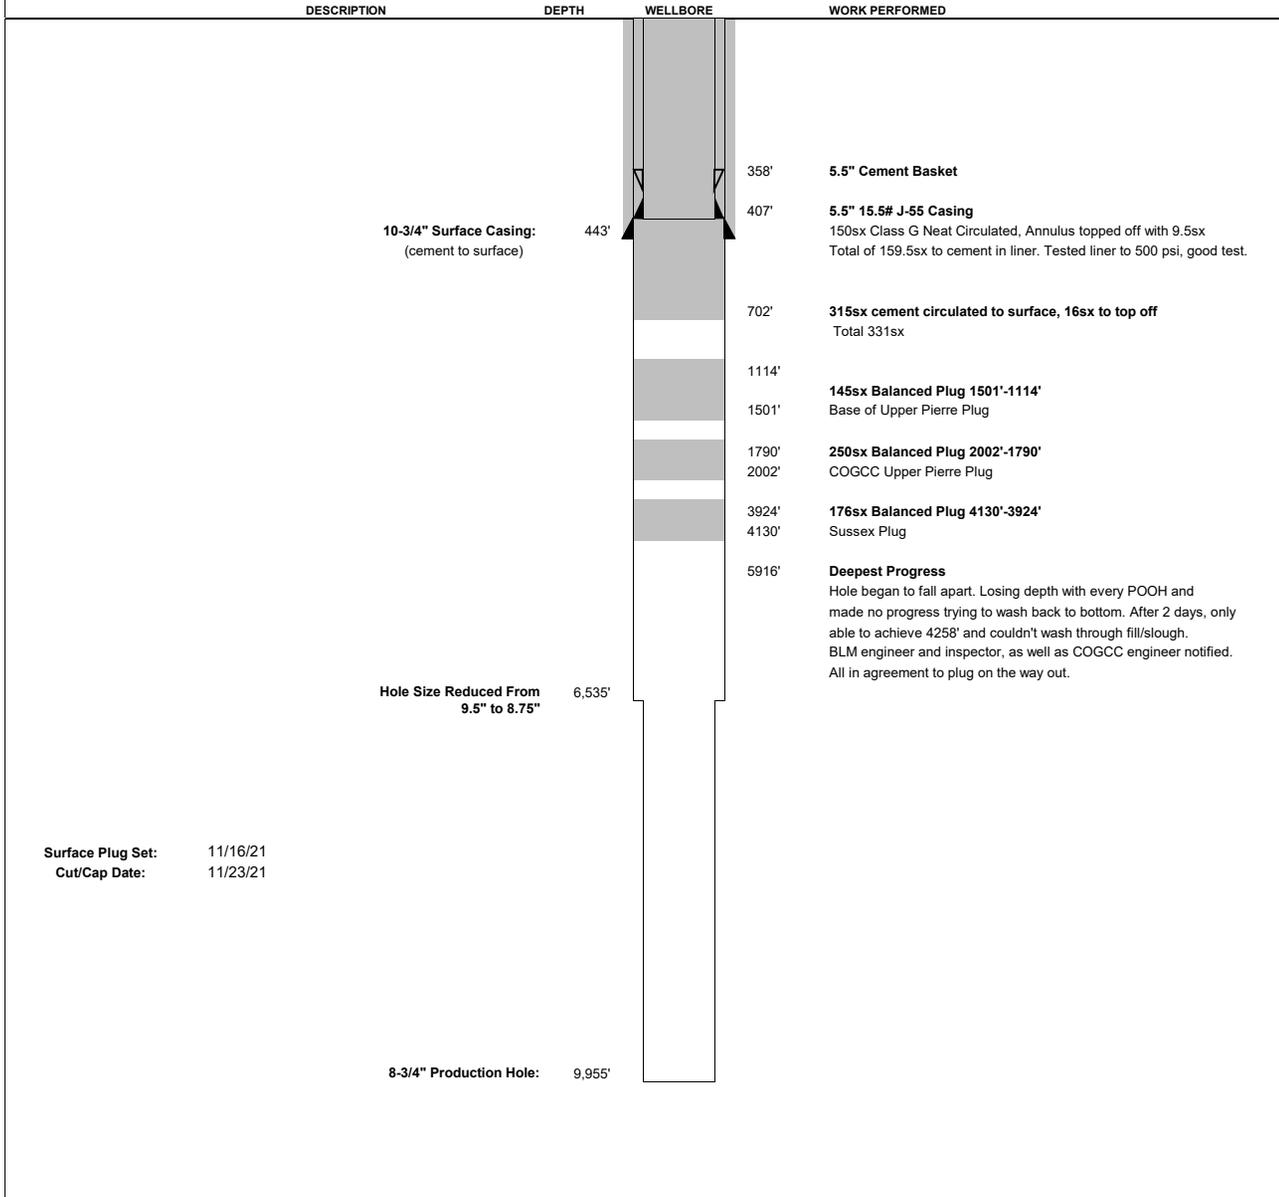

WELL: Colorado National Bank #1

LOCATION: NENE 12 8N 60W
563FNL 677 FEL (Planned)
40.682805°N, -104.031361°E

FORMATION:

API #: 05-123-05582

Field: Wildcat

CURRENT STATUS: DA

Spud: 08/31/57

Casing and Tubular Data

Type	Size	Weight	Top	Bottom	Hole Size
Surface	10-3/4"	40.5 ppf	0	443'	13-3/4"
Top Production	None		0	6,535'	9.5"
Bottom Production	None		6,535'	9,955'	8.75"

Elevation Data

GL	4976	feet
KB	4986	feet
Difference	10	feet

Formation Tops Data

Formation	Depth	
Base of Fox Hills	581'	MD
Base of Upper Pierre	1600'	MD
Niobrara	6129'	MD