


Colorado National Bank #1 After P&A

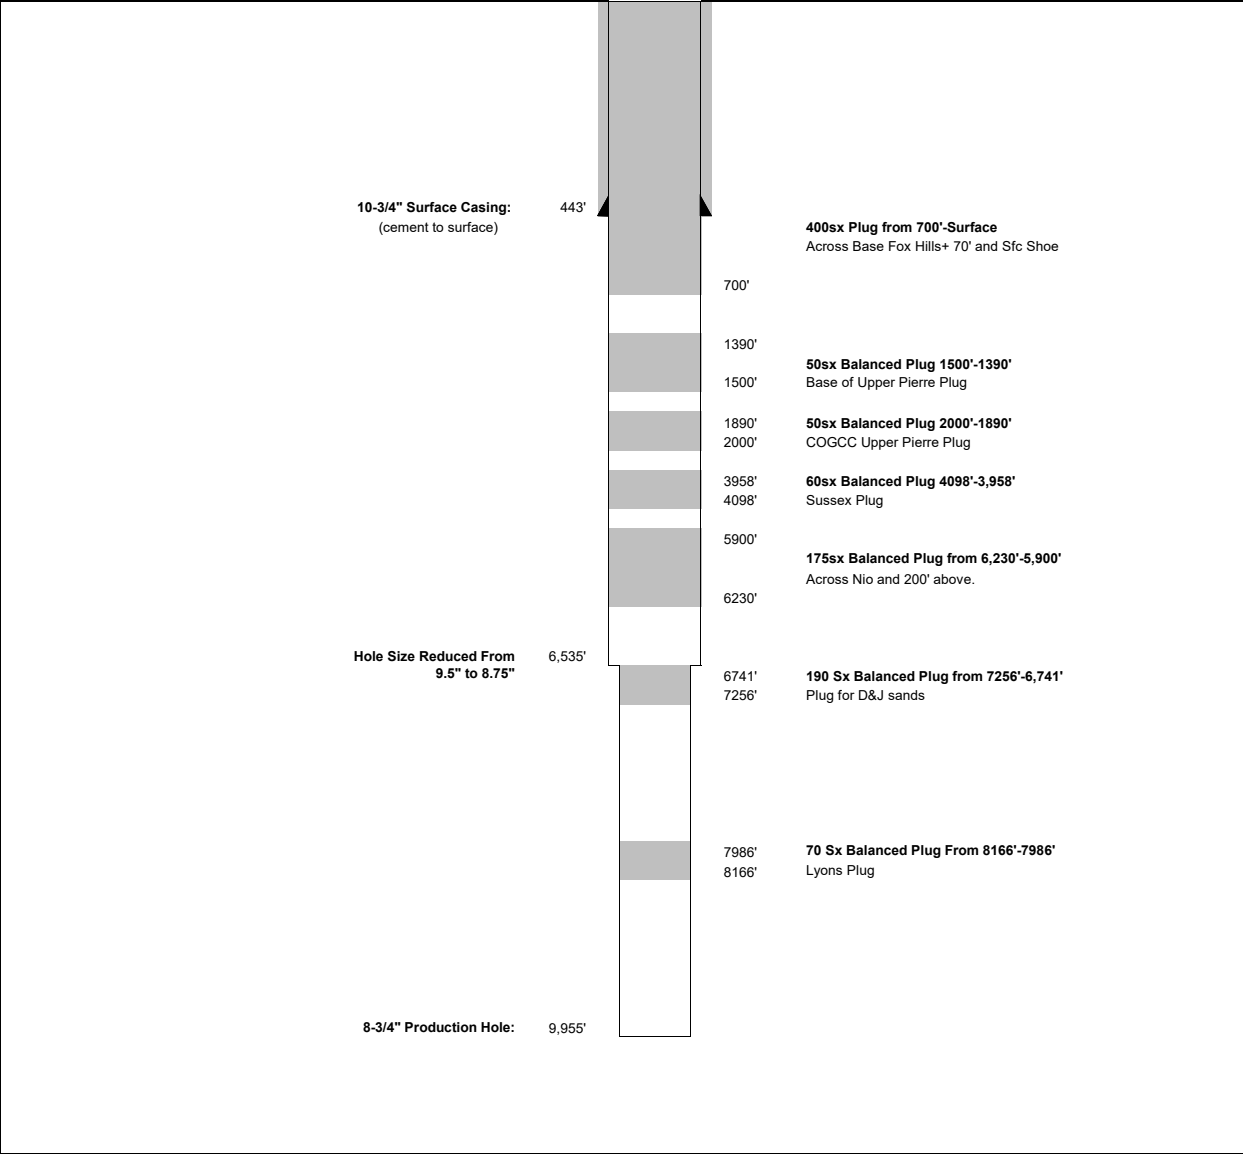

WELL:	Colorado National Bank #1			
LOCATION:	NENE	12	8N	60W
	563FNL	677 FEL	(Planned)	
	40.682805°N, -104.031361°E			
FORMATION:	NBRR	2005		
API #:	05-123-05582			
Field:	Wildcat			
CURRENT STATUS:	DA			
Spud:	08/31/57			

Casing and Tubular Data					
Type	Size	Weight	Top	Bottom	Hole Size
Surface	10-3/4"	40.5 ppf	0	443'	13-3/4"
Top Production	None		0	6,535'	9.5"
Bottom Production	None		6,535'	9,955'	8.75"

Elevation Data		
GL	4976	feet
KB	4986	feet
Difference	10	feet

Formation Tops Data		
Formation	Depth	
Base of Fox Hills	581'	MD
Base of Upper Pierre	1600'	MD
Niobrara	6129'	MD