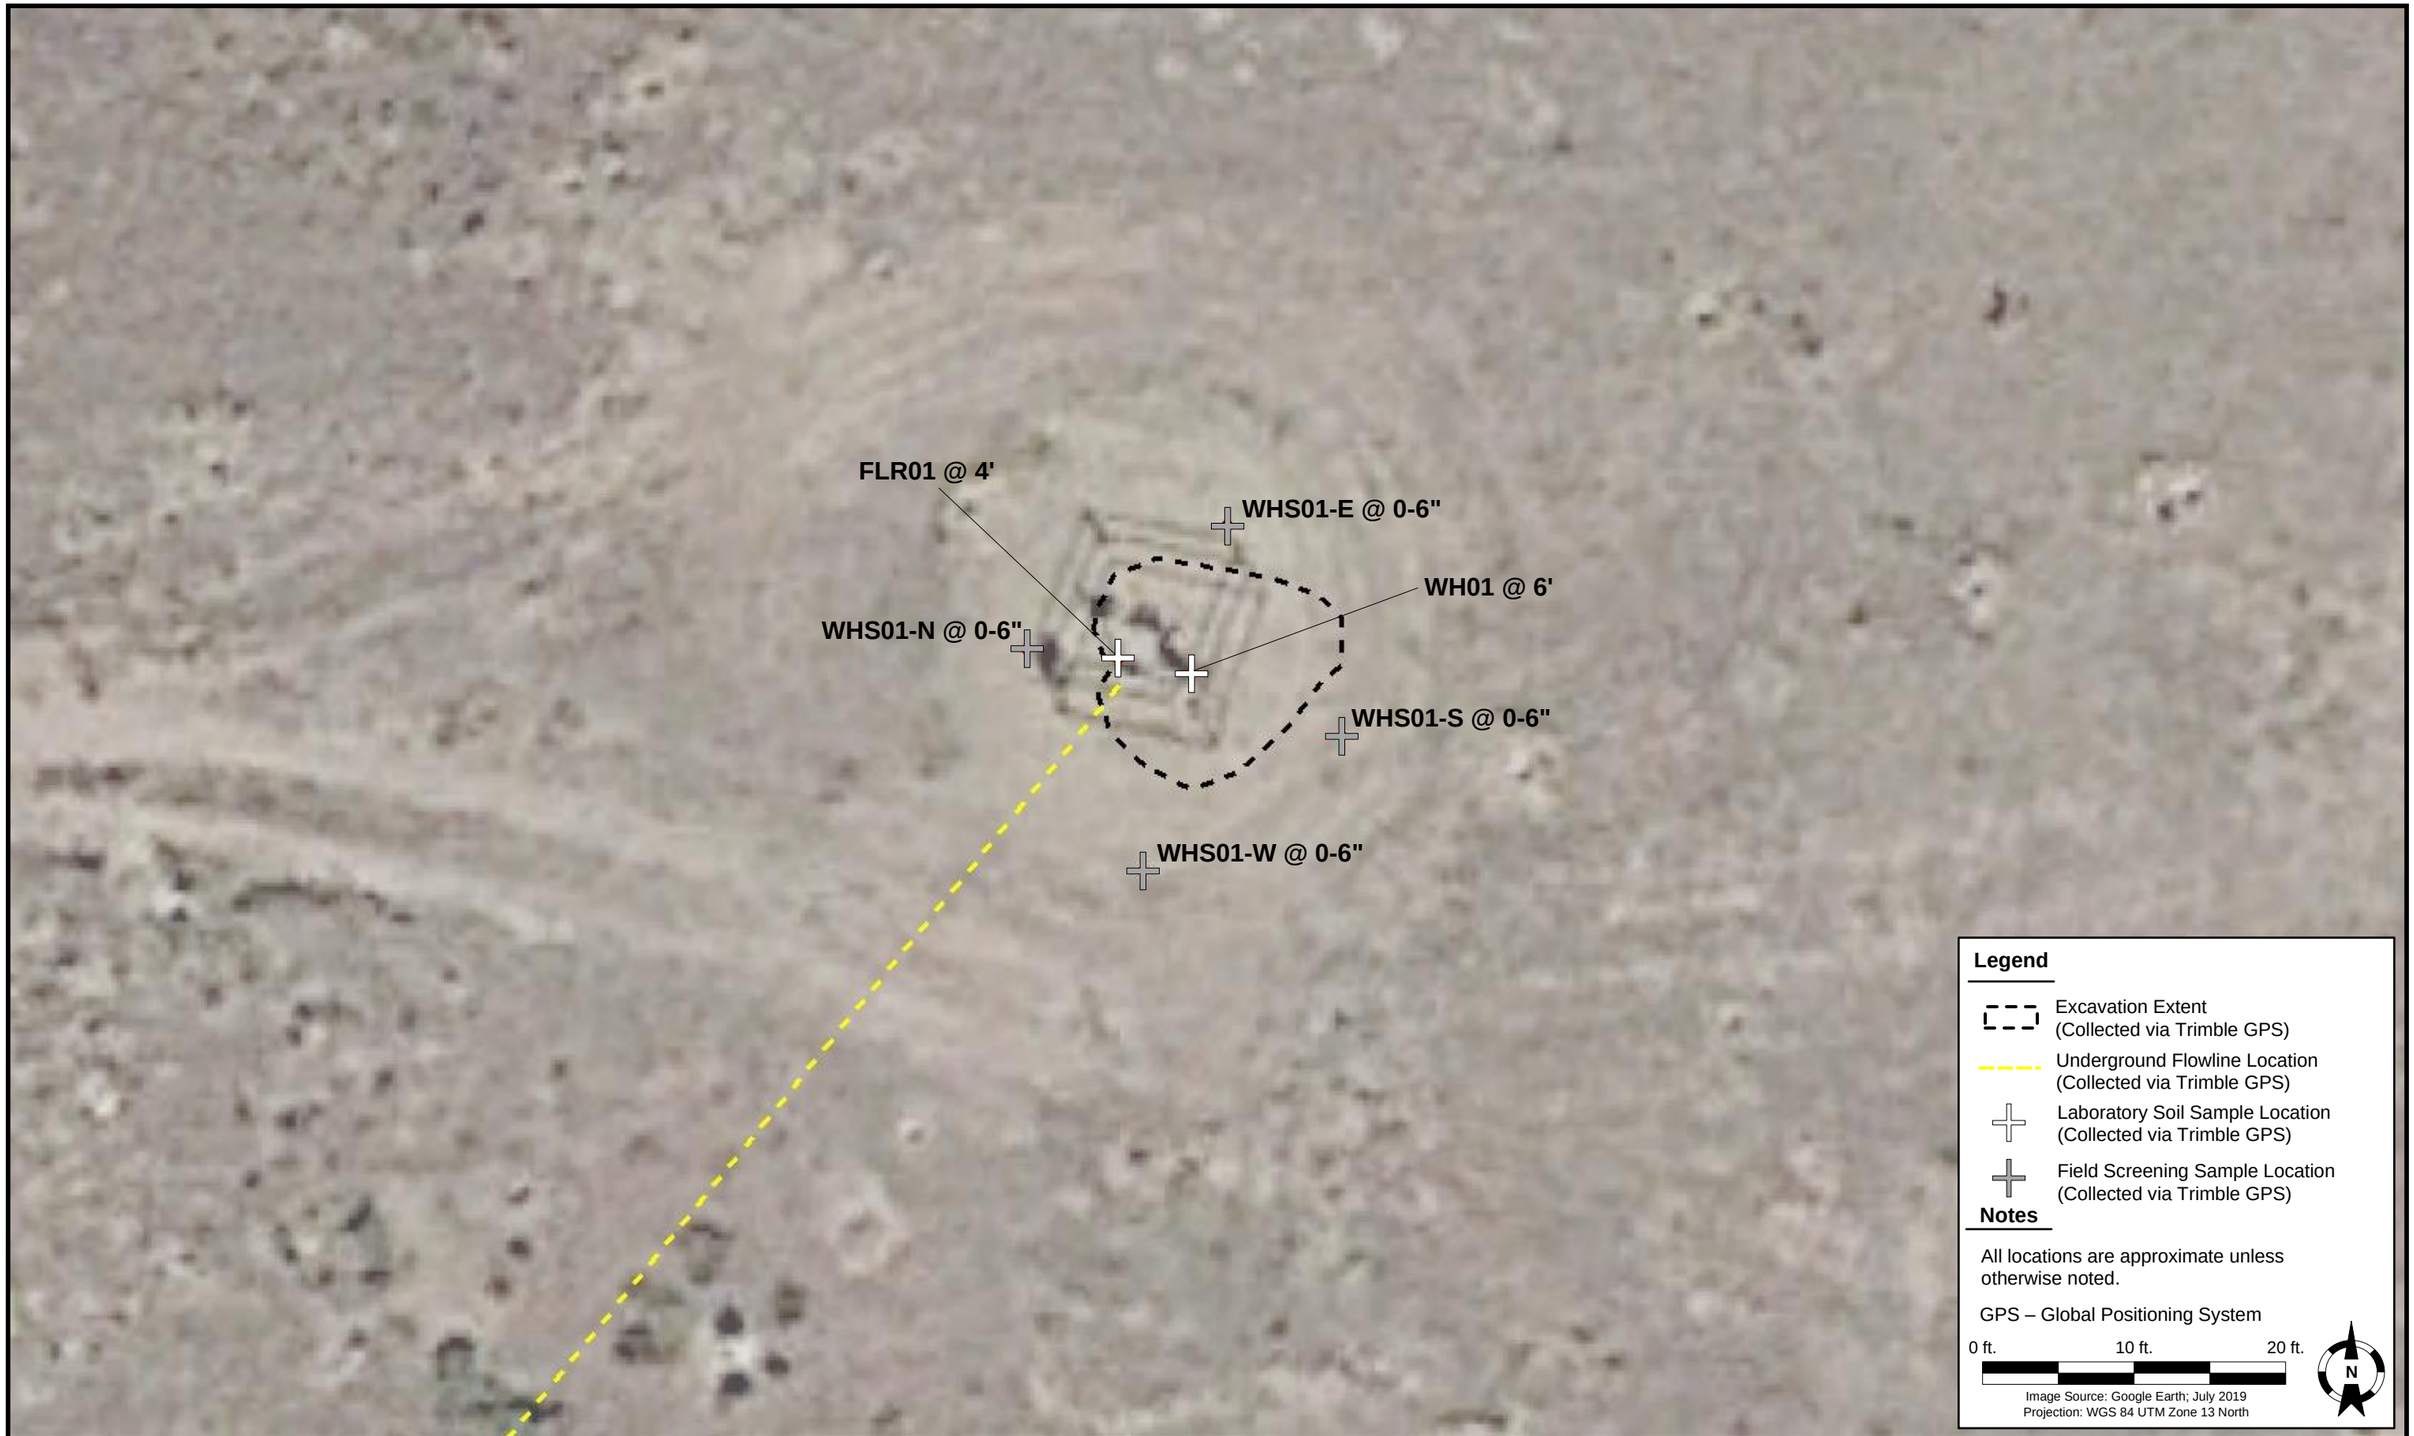

DATE: September 15, 2021

DESIGNED BY: C. Hamlin

DRAWN BY: J. Clonts

TASMAN GEOSCIENCES

Tasman Geosciences, Inc.
6855 W. 119th Ave.
Broomfield, CO 80020

PDC Energy, Inc. – DJ Basin
Former Buffalo Gardens 41-13 Wellhead
NENE, Section 13, Township 2 North, Range 68 West
Weld County, Colorado

SOIL SAMPLE LOCATION MAP (WELLHEAD)

FIGURE 1