
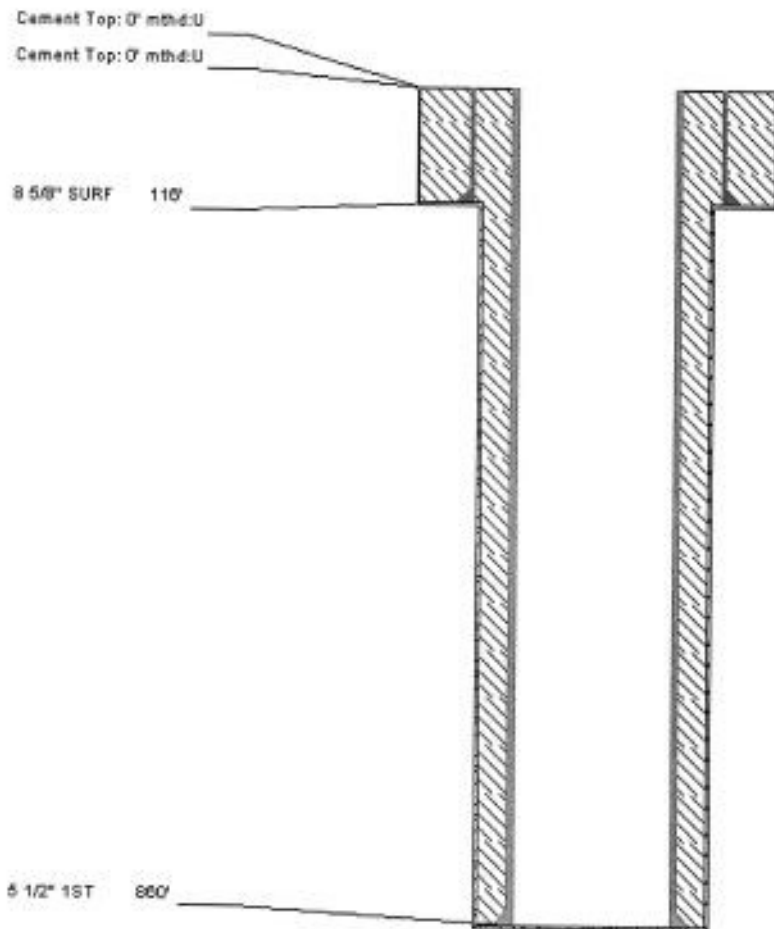


Well Completion Diagram

API Well No: 05-007-06117-00-					
Owner:	ALAMOSA DRILLING INC			Well Name:	NIELSEN 4
County:	ARCHULETA	Field:	NAVAJO	Pool:	
Coordinates: X	359 FEL	Y	211 FNL	Sec:	18
				Twp:	32N
				Rng:	1E

Note: Changes to the drawing do not effect the database

Bore Diameters (in.)

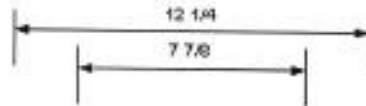

Total Vertical Depth 1,190'