


# LILLI UNIT T8N-R58W-S4 L01

## FACILITY DECOMMISSION

LAT	40.683718
LONG	-103.869508

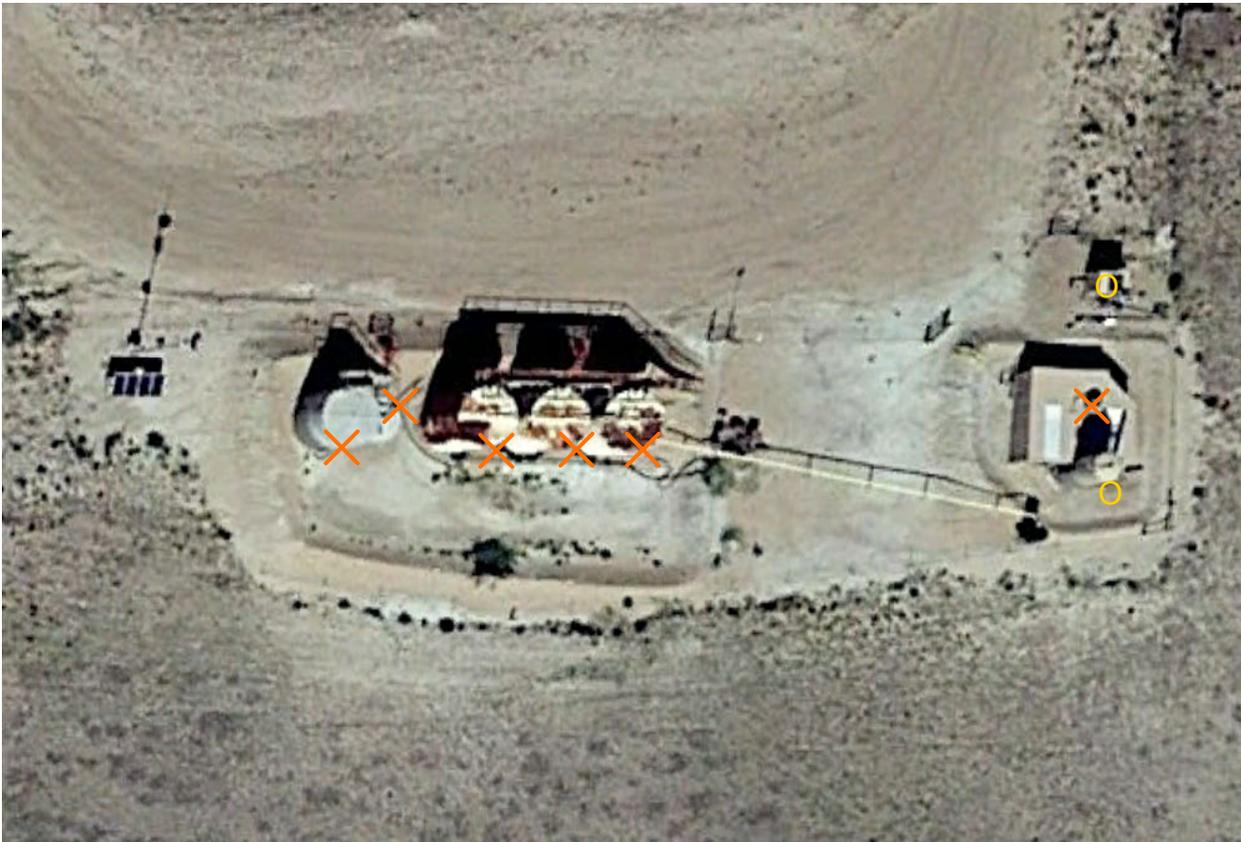

X	Soil Sample Location
O	Field Screening Location