

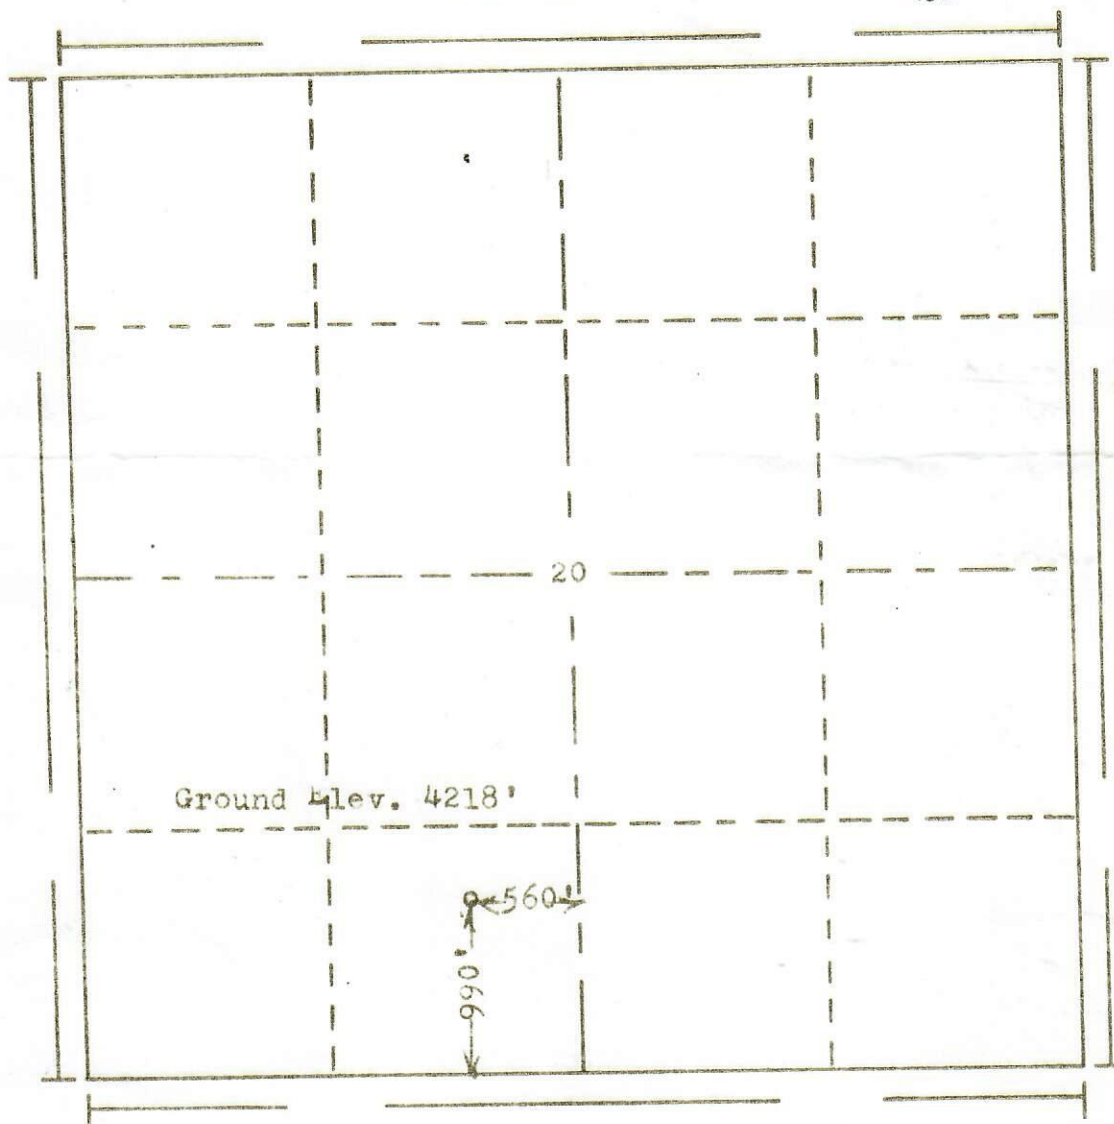


RECEIVED N

JUN 16 1973

R. 53W

COLO

T.
9
N

Scale... 1" = 1000'

Powers Elevation Company, Inc. of Denver, Colorado
has in accordance with a request from Mr. Arbuckle
for Kimbark Operating Co. & The Columbus Corp.
determined the location of No. 1 Green
to be 990' FS & 560' FE of SW $\frac{1}{4}$ Section 20 Township 9N
Range 53W of the 6th Principal Meridian
Logan County, Colorado

I hereby certify that this plat is an
accurate representation of a correct
survey showing the location of

Date: 1-2-73

Eric G. Hall

Licensed Land Surveyor No. 2853
State of Colorado