




00270136

R. 53W

RECEIVED

JUN 16 1973

GOLD

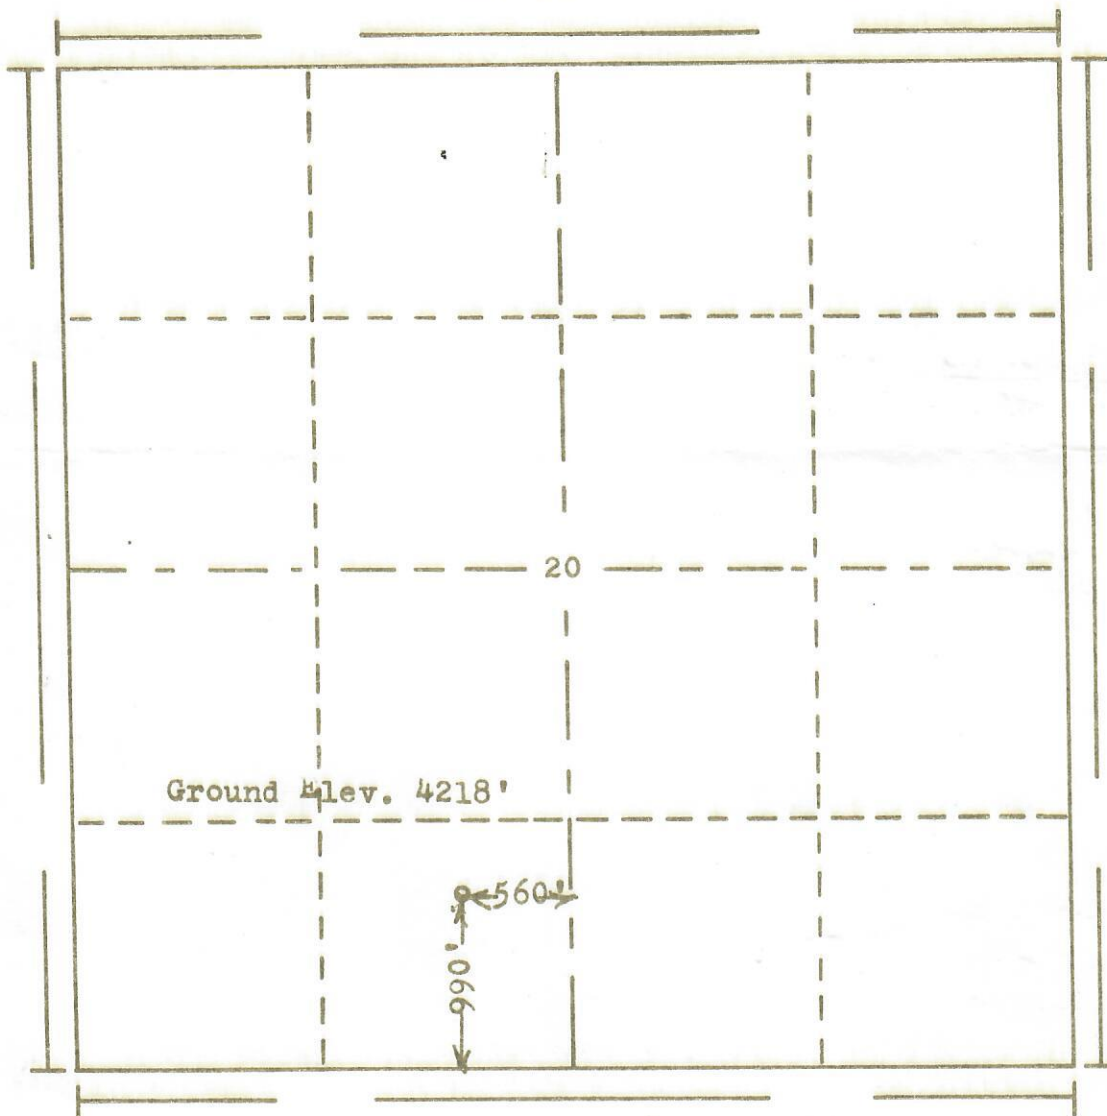

Ground Elev. 4218'

Scale... 1" = 1000'

Powers Elevation Company, Inc. of Denver, Colorado  
has in accordance with a request from Mr. Arbuckle  
for Kimbark Operating Co. & The Columbus Corp.  
determined the location of No. 1 Green  
to be 990'FS & 560'FE of SW $\frac{1}{4}$  Section 20 Township 9N  
Range 53W of the 6th Principal Meridian  
Logan County, Colorado

I hereby certify that this plat is an  
accurate representation of a correct  
survey showing the location of

Date: 1-2-73

B. J. Hall  
Licensed Land Surveyor No. 2853  
State of Colorado

72-1109