


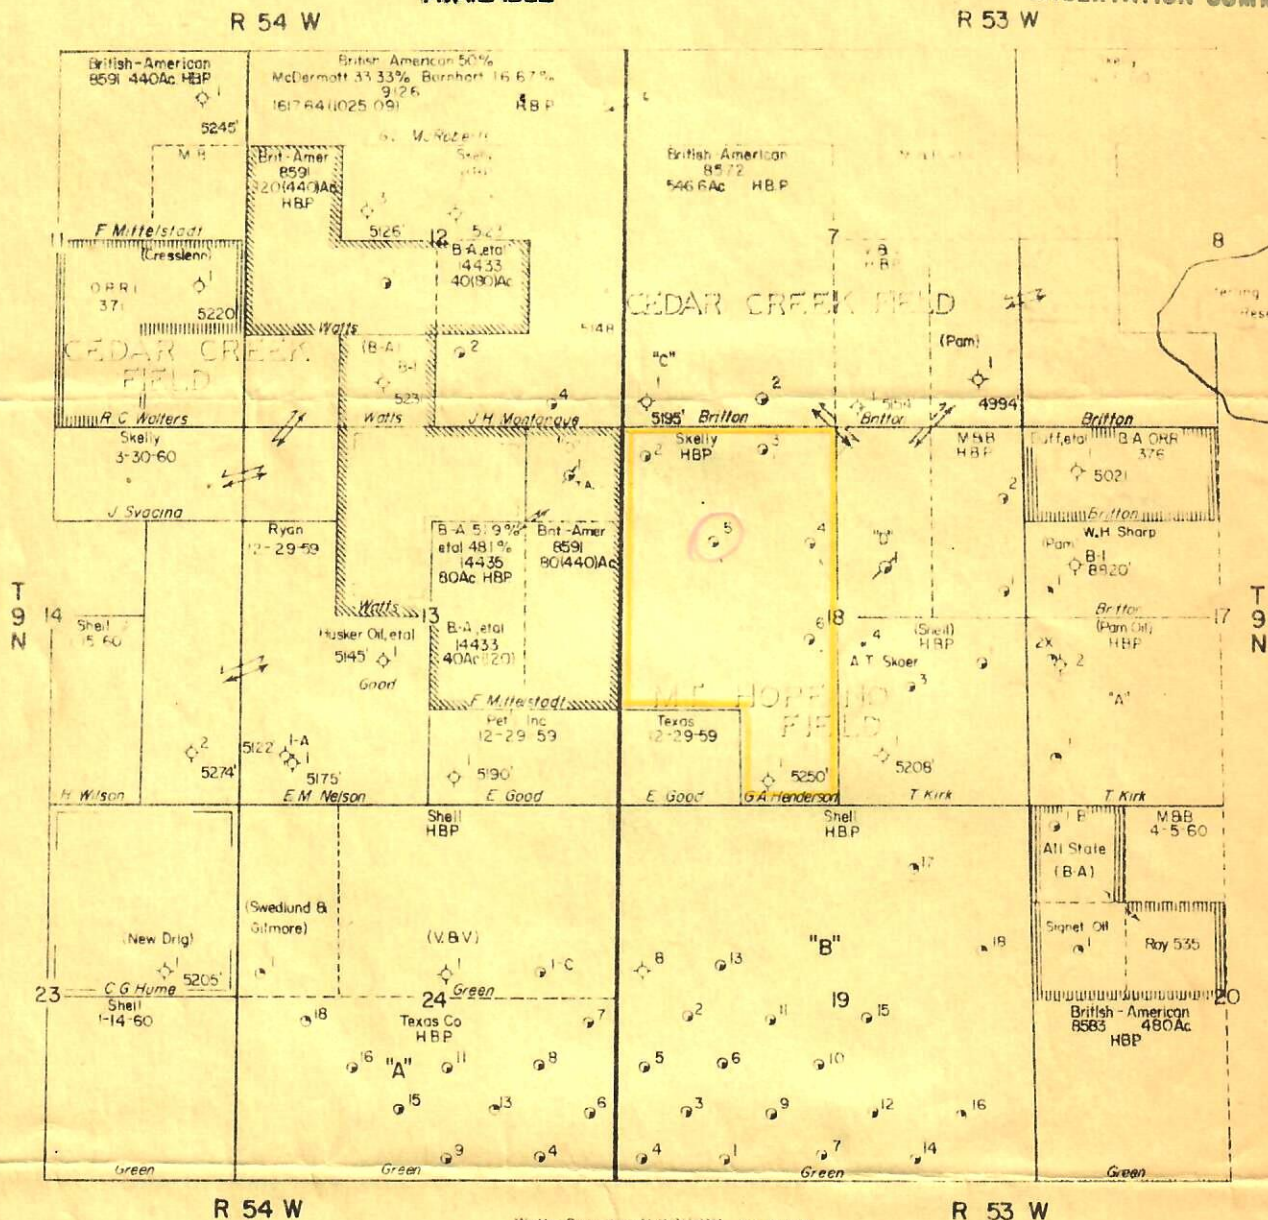

00250998

RECEIVED  
MAR 21 1962BEST IMAGE  
AVAILABLEOIL & GAS  
CONSERVATION COMMISSION

Watts Operating Unit No 16853

British-American 50%  
Vaughy B Vaughy 19.231%  
Barnhart 8.973%  
McDermott 17.950%  
Tenn Gas 19.23%

- Location
- Dry Hole
- Drilling Well, Abandoned
- Producing Oil Well
- Producing Gas Well
- Salt Water Disposal Well
- Input Well (Injection)
- Output Well (Water Supply)
- Temporarily Abandoned Well
- Oil Production Exhausted (P & A)
- Gas Production Exhausted (P & A)

PRODUCING ZONES

- Q' Sand
- Q'J' Sand

SCALE  
1000' 0' 1000' 2000' 3000'CEDAR CREEK  
&  
MOUNT HOPE  
AREAS  
LOGAN COUNTY, COLO.

REVISED