




R. 56W

RECEIVED

AUG 7 1974

GOLD. OIL & GAS CONS. COMM.

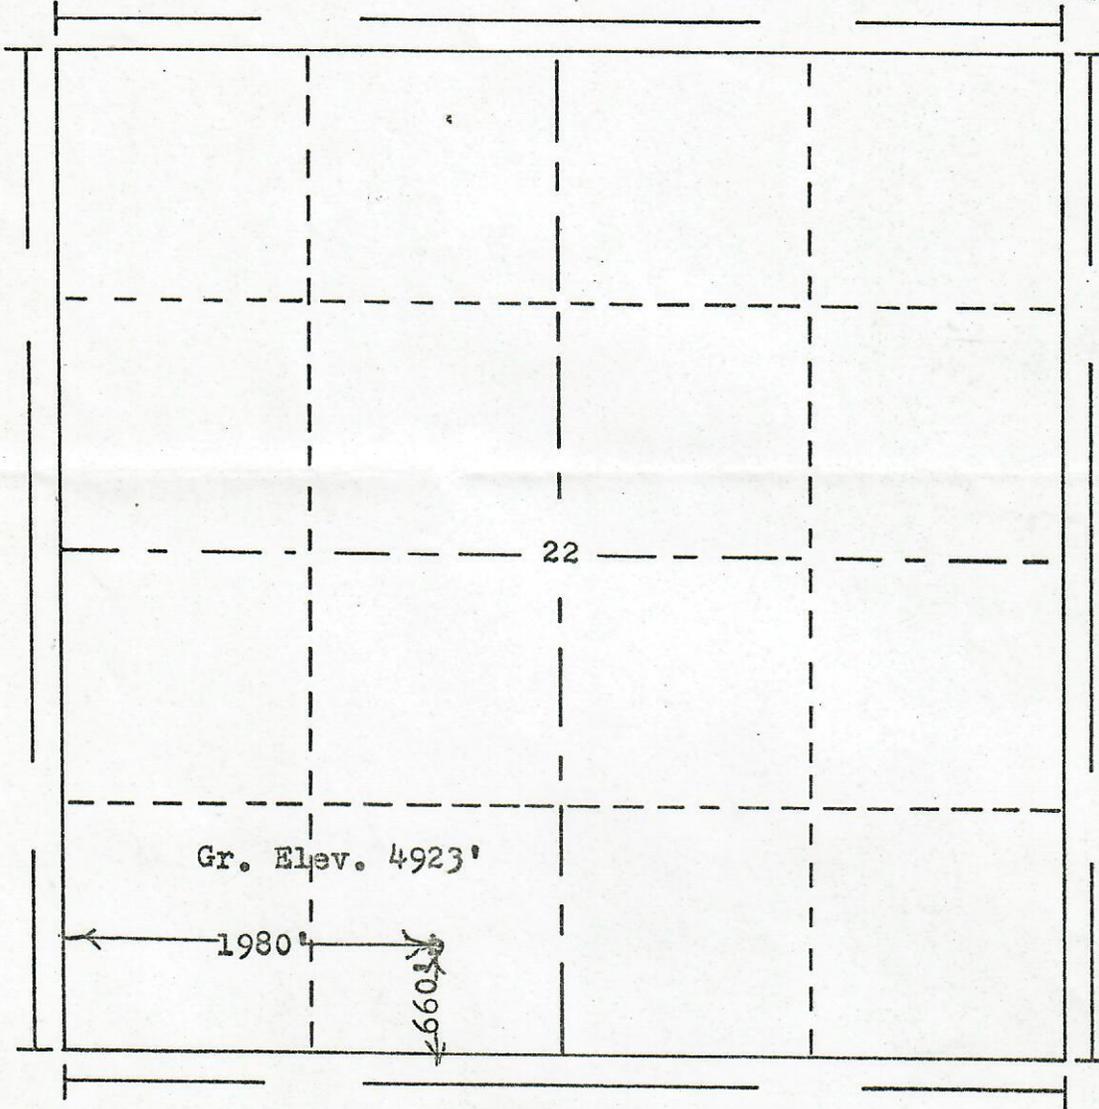

Scale... 1" = 1000'

Powers Elevation Company, Inc. of Denver, Colorado has in accordance with a request from Mr. Wilson for Petroleum Inc.

determined the location of No.7 Buczkowskyj to be CSE SW Section 22 Township 12N Range 56W of the 6th Principal Meridian Weld County, Colorado

I hereby certify that this plat is an accurate representation of a correct survey showing the location of

Date: 7-23-74

*Billy G. Hallway*

Licensed Land Surveyor No. 2853 State of Colorado