




Schematic - Directional

TD: 12,676.0

Well Name: Lofland 22T-402

Spud Date 1/14/2014	Rig Release Date 1/27/2014	API 05123378110000	Surface Legal Location SESE 22 5N 65W	Orig KB Elev (ft) 4,663.00	Ground Elevation (ft) 4,648.00	Total Depth (ftKB) 12,676.0	Total Depth All (TVD) (ftKB) Original Hole - 6,981.4
------------------------	-------------------------------	-----------------------	--	-------------------------------	-----------------------------------	--------------------------------	---

Horizontal, Original Hole, 12/29/2021 6:21:21 PM

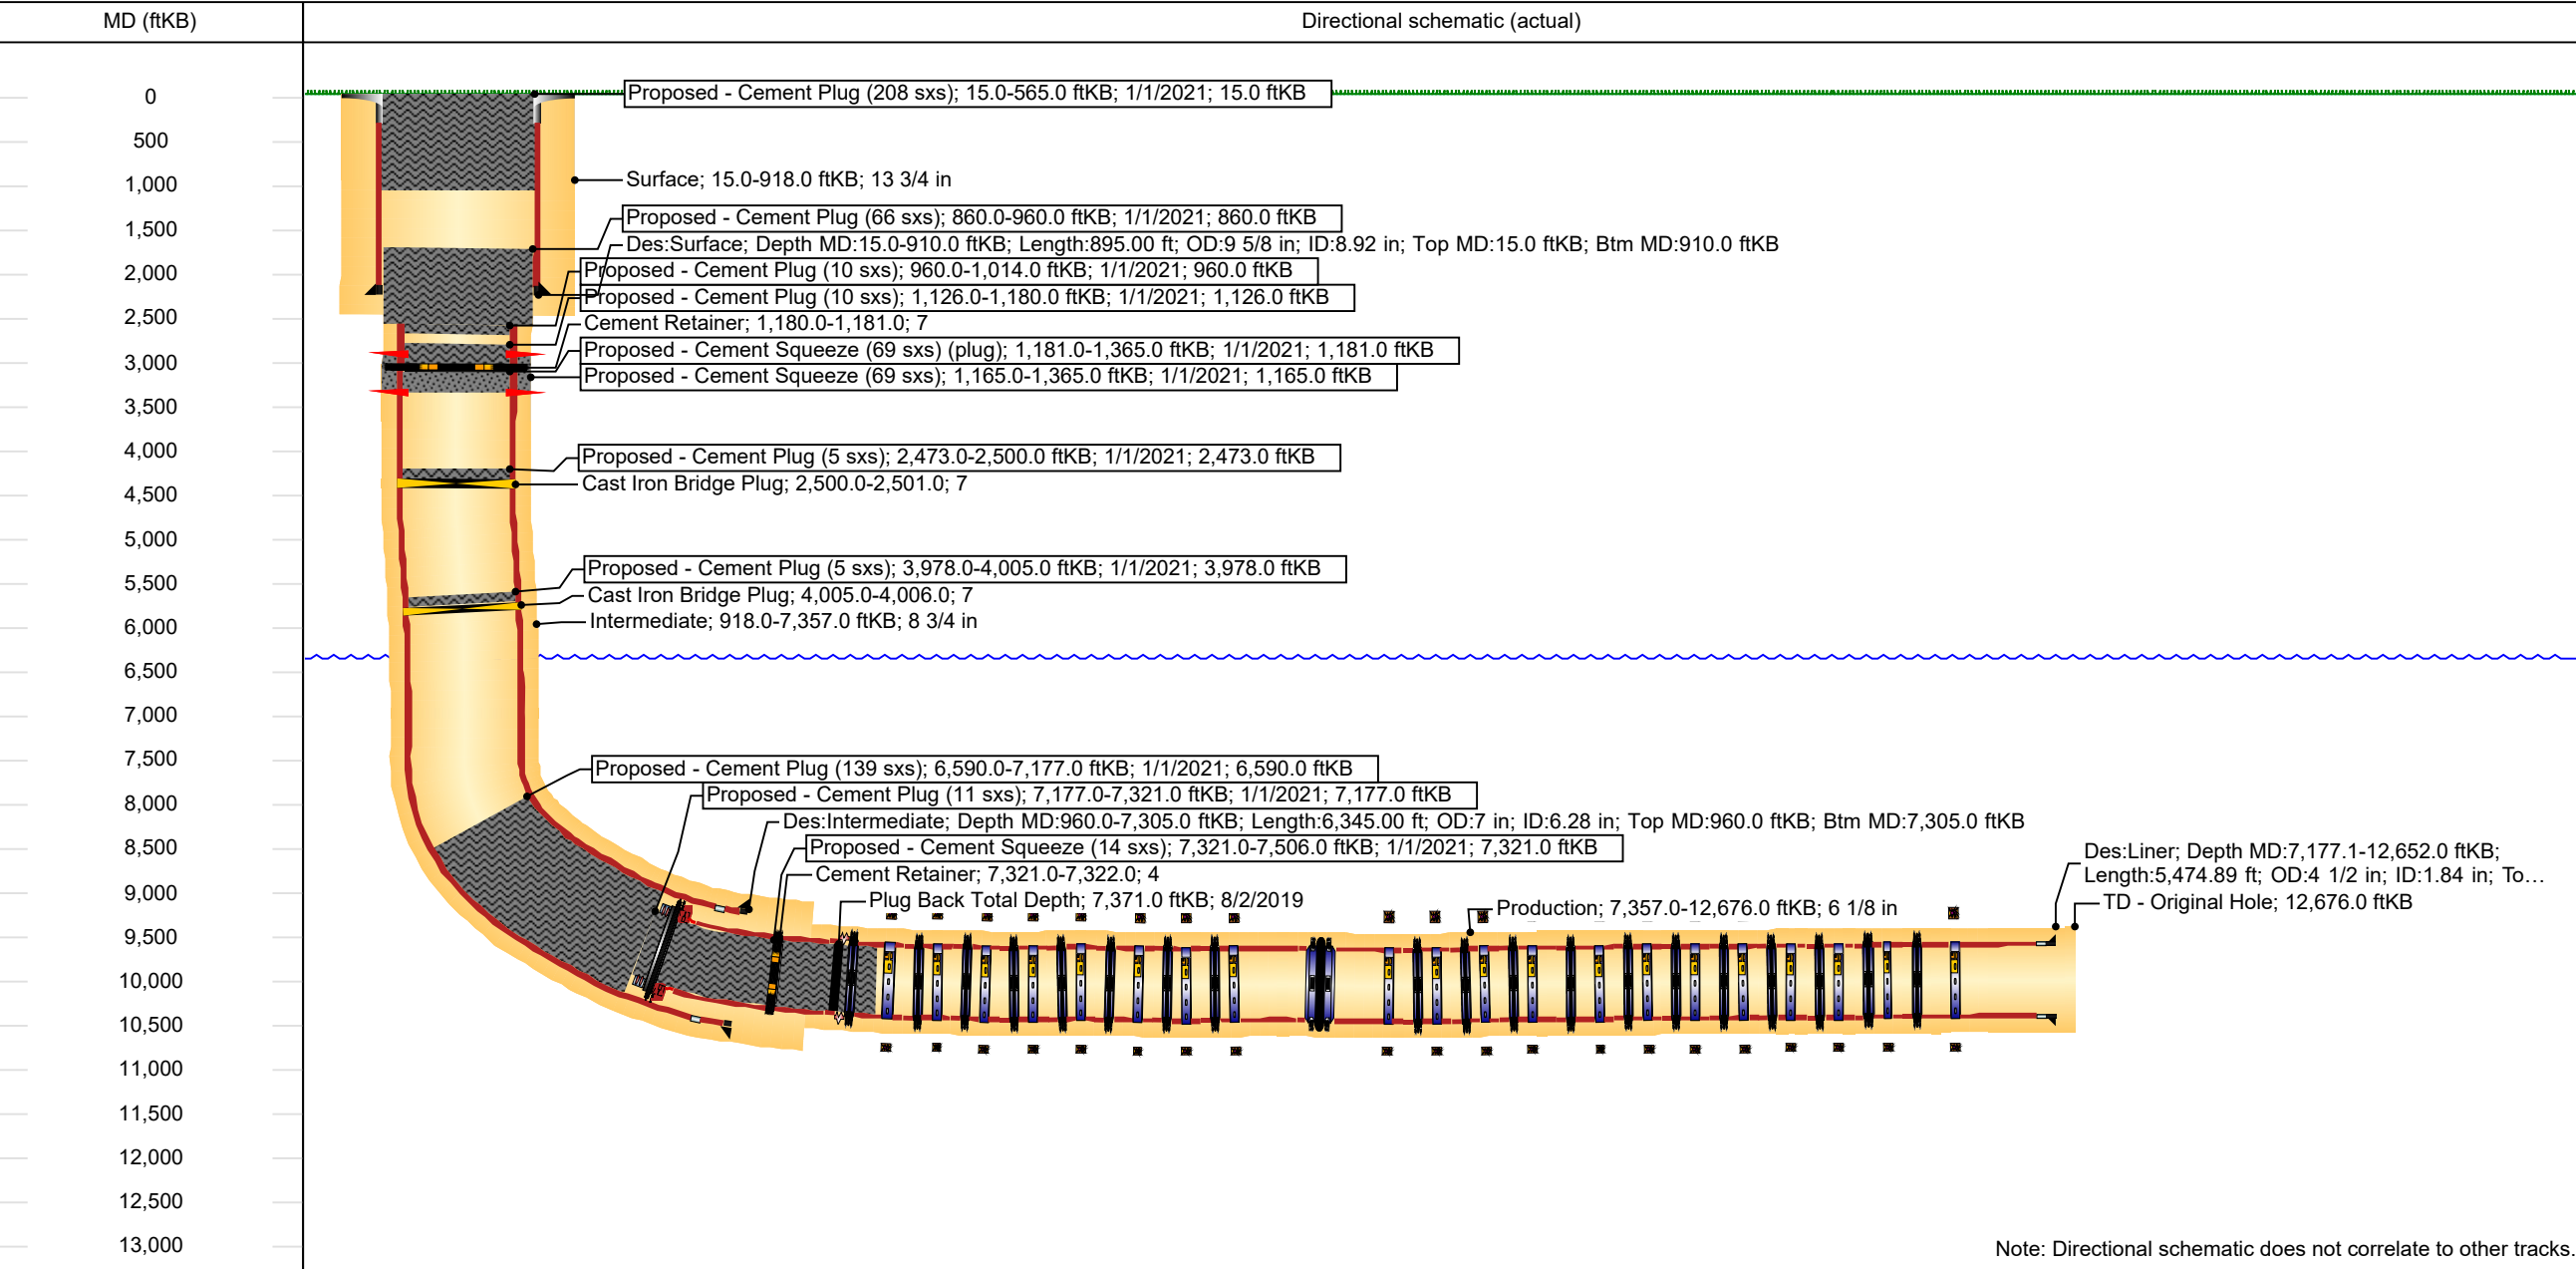

Note: Directional schematic does not correlate to other tracks.