


**Nashland 1**  
**SWSW, Section 24-T7N-R67W**  
**Weld County, CO**  
**API No. 05-123-05340**

Actual Post PA

NOTE: Well is vertical well

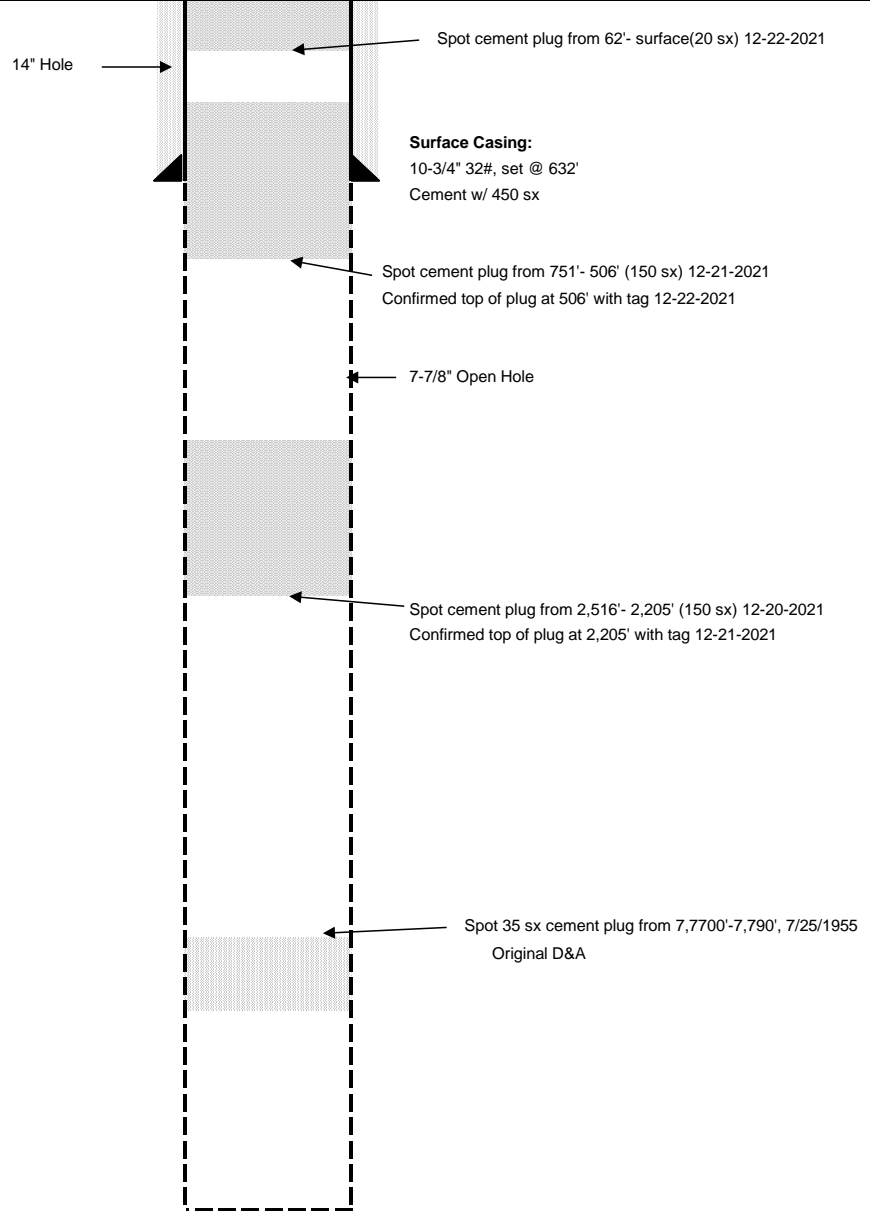

TD @ 9,224

Date: 1/4/2022

By: Kevin Kane