


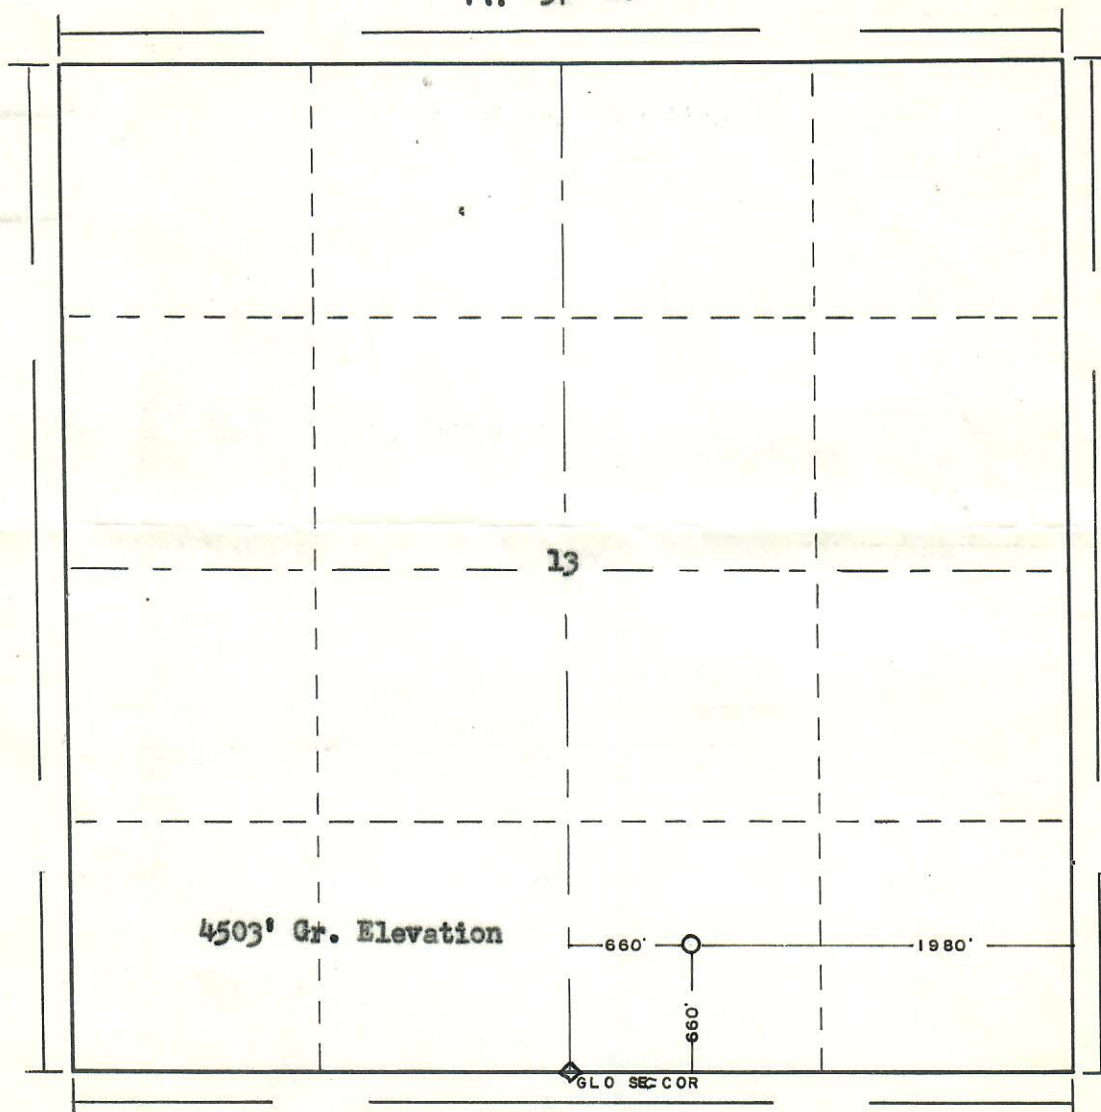

00270888

R. 57 W.

T.
9
N.

Scale ... 1" = 1000'

Powers Elevation Company of Casper, Wyoming
has in accordance with a request from **Bob Norris**
for **Northern Natural Gas Producing Company** determined the
Location of **#1 McKenzie**
to be **C SW SE** Section 13 Township 9 North,
Range 57 West 6th Principal Meridian
Weld County, Colorado.

The above Plat shows the location of the well site
in said section.

Powers Elevation Company

by: *Burr Leibert*

Date: 4-20-57

Registered Land Surveyor

Burr Leibert

