


00788833
JAN 17 1966
OIL & GAS
CONSERVATION COMMISSION

R. 53W

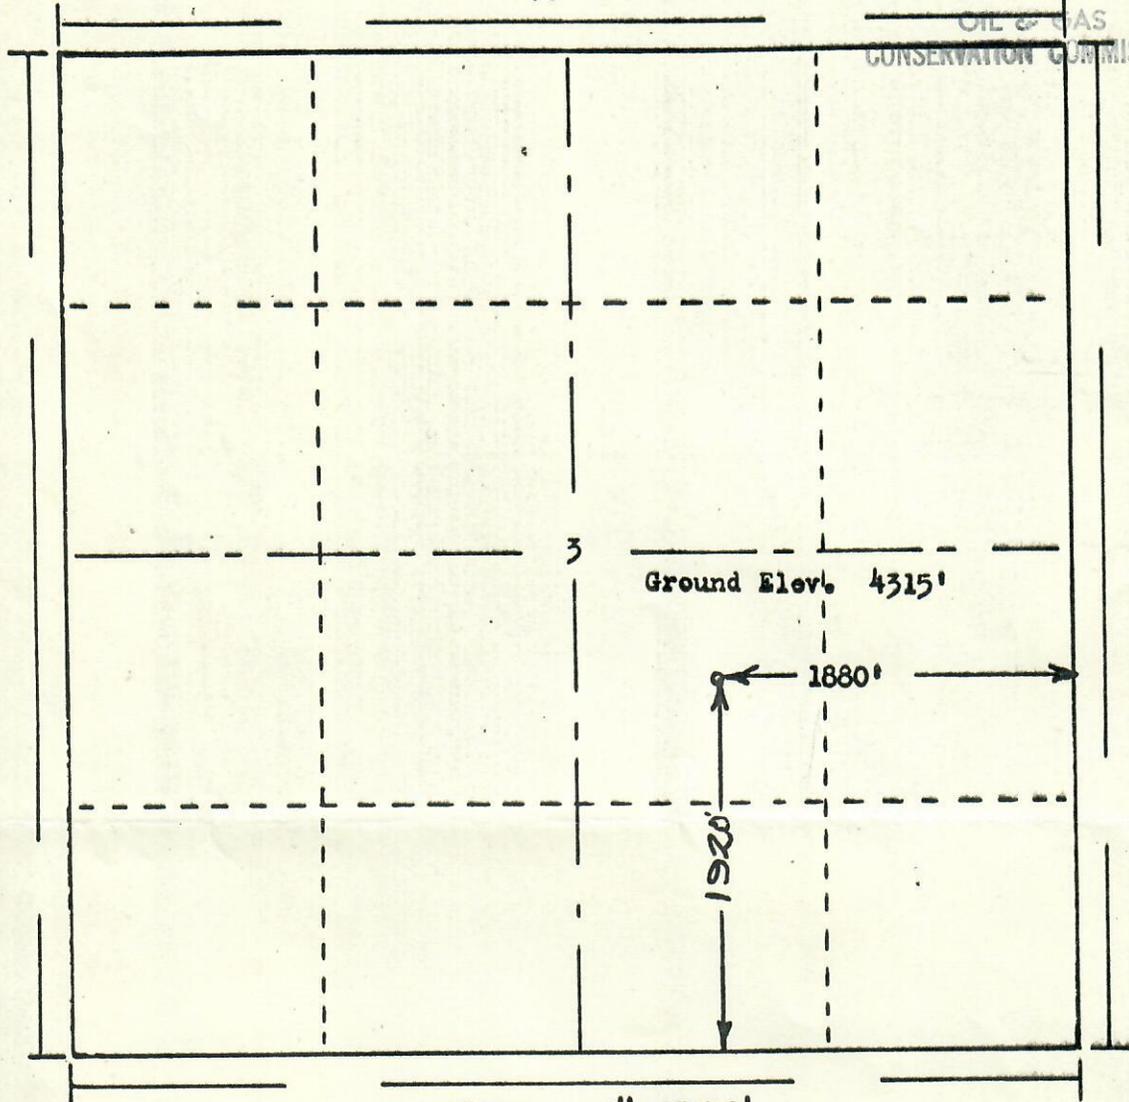

T.
10
N

Scale ... 1" = 1000'

Powers Surveyors, Inc. of Denver, Colorado
has in accordance with a request from Mr. Winslow
for Don Winslow determined the
Location of No. 1 State "B"
to be 60' South & 100' East Section 3 Township 10N
Range of CNW SE 53W of the 6th Principal Meridian
Logan County, Colorado

I hereby certify that this plat is an
accurate representation of a correct
survey showing the location of

Date: 11-20-65

Betty G. Holloman
Licensed Land Surveyor No. 2853
State of Colorado