

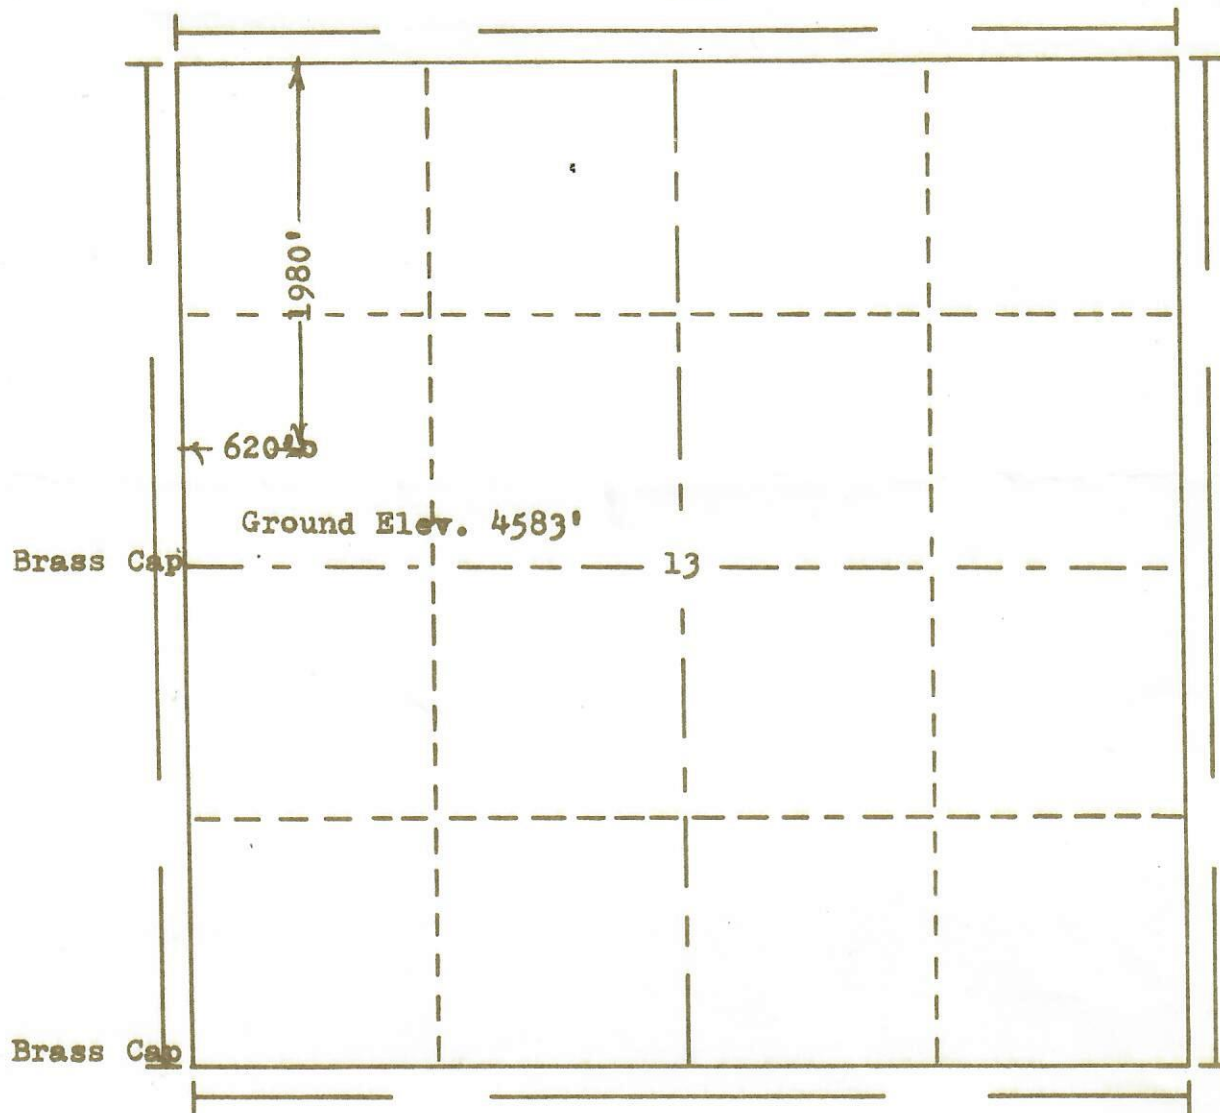


RECEIVED

NOV 8 1968

R. 57W

COLO. OIL & GAS CONS. COMM.

T.
9
N

Scale... 1" = 1000'

Powers Elevation Company, Inc. of Denver, Colorado
has in accordance with a request from Mr. Miller
for A&M Associates
determined the location of No.1 Hoffman-Lousberg
to be 1980'FN & 620'FW Section 13 Township 9N
Range 57W of the 6th Principal Meridian
Weld County, Colorado

I hereby certify that this plat is an
accurate representation of a correct
survey showing the location of

Date: 10-18-68

B. G. Holladay

Licensed Land Surveyor No. 2853
State of Colorado