




# OIL AND GAS CONSERVATION COMMISSION OF THE STATE OF COLORADO

## NOTICE OF INTENTION TO DRILL

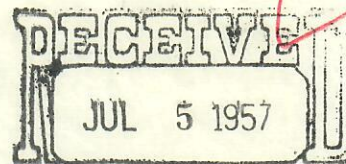

OIL &amp; GAS

CONSERVATION COMMISSION

### INSTRUCTIONS:

A notice of intention to drill a well shall be filed in duplicate on all Federal and Patented lands, and in triplicate on all State lands. Do not begin operations until approved copy has been received. It is mandatory that the proposed location comply with all rules and regulations of the Commission. Locate well on section grid in proper location, and indicate extent of lease. Unless operations are commenced within 180 days after the date of approval hereof, this approval to drill will become null and void.

Name of Operator NORTHERN NATURAL GAS PRODUCING COMPANY Phone No. AL-5-7015  
Address 202 Mile High Center City Denver State Colorado


How is liability secured: Well Bond (Attached) ☐; Blanket Bond ☐; Waiver ☒  
(Check one)

Lease Name McKenzie-FIB

Well No. 1-A

Field Name McKenzie Wildcat ☐

County Weld

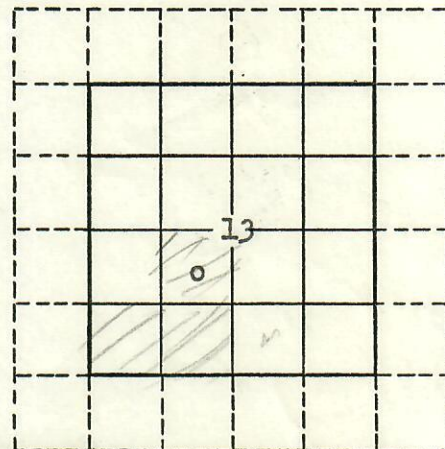

Location C NE SW (quarter quarter) Section 13 Township 9N Range 57W Meridian 6th  
1980 feet from South Section line and 1980 feet from West Section Line  
N or S E or W

The well is located on: Patented land ☒ State land ☐ Federal land ☐

The well is located within a spaced area: Yes ☐ No ☒

Distance from proposed location to nearest property or lease line 660 feet.

Distance from proposed location to nearest drilling unit line          feet.

Objectives: "J" Sand Depth 6000 feet;          Depth           
Formation Estimate Formation Estimate

Proposed length of surface casing 200 feet.

REMARKS:

AJJ	
DVR	
FJK	
WRS	
HH/A	
AH	
JJD	<input checked="" type="checkbox"/>
FILE	

I/We hereby swear (or affirm) that the statements herein made are a full and correct report.

APPROVED:

Date 7/5/57

A. J. Gerain  
Director by J.P.

Company NORTHERN NATURAL GAS PRODUCING COMPANY Date July 5, 1957

Address 202 Mile High Center Phone No. AL 5-7015

By Adam M. Butler Title Landman  
Adam M. Butler Signature