


Well Name: MOSER H34-10

VERTICAL, ORIGINAL HOLE, 1/12/2022 9:37:16 AM

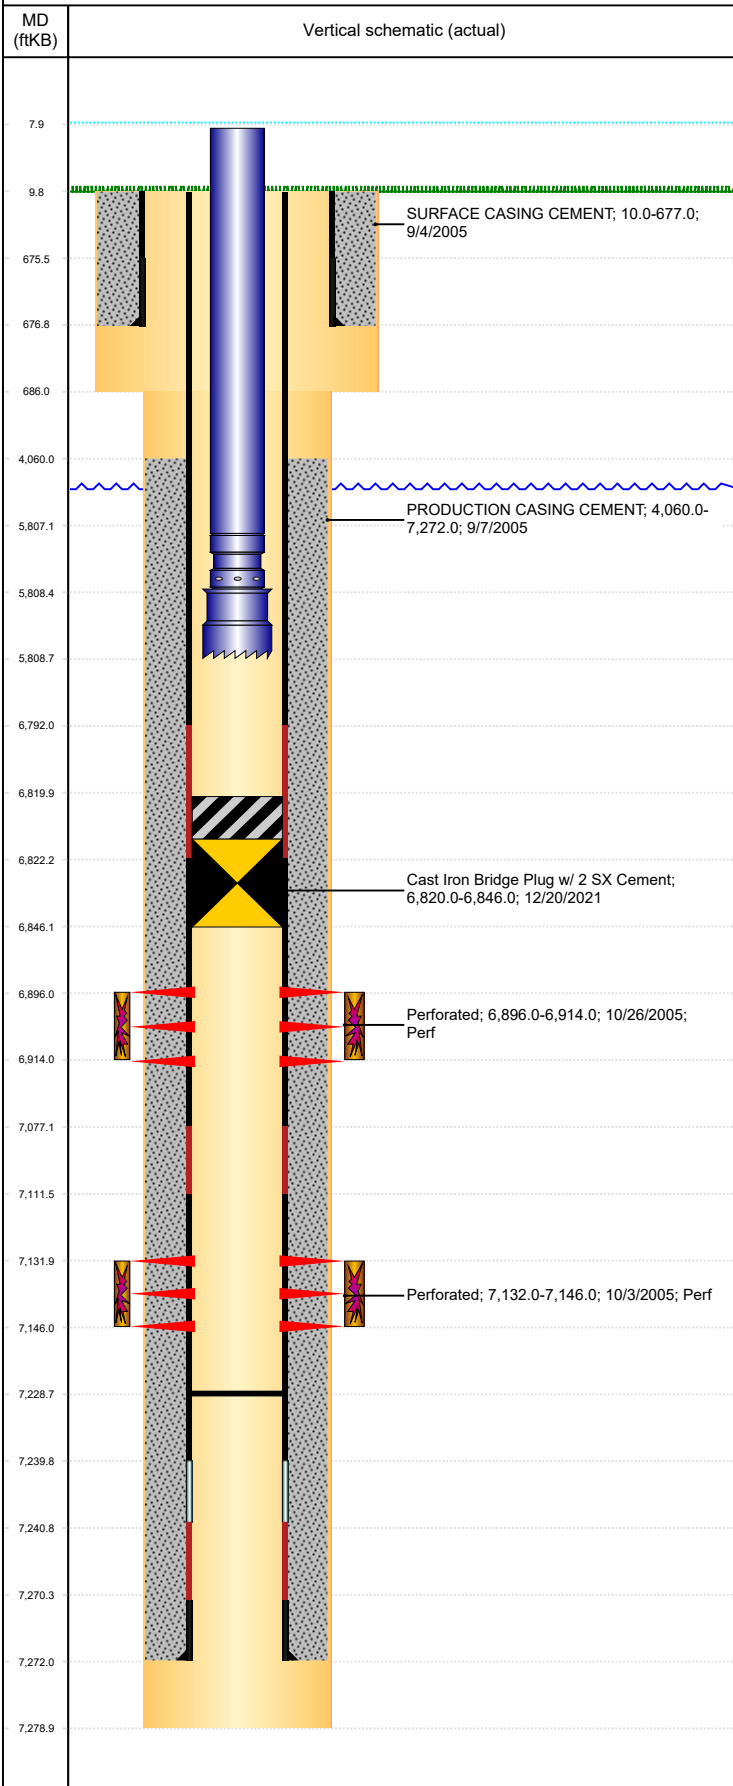

Well Header									
API 05-123-23197		Business Unit DJ BASIN			District 15		Well Config VERTICAL		
KB - GL / MSL (ft... 10.00		Spud Date 9/3/2005		P & A Date		Well Production Status TA			SoRT No
Comment DISCREPENCIES: SPUD DATE- ST 9/4/05, DRL RPT 9/3/05; PROD CSG SET DEPTH - ST 7273', DRL RPT 7272', USED 7272'. 10/19/05 CODELL FRAC SCREENED OUT - ABORT REMAINDER OF TREATMENT. FIELD OPS NOTICE- FLOWLINES ABANDONED PER RULE 1103, RCVD 8/22/17.									
Surface Location (Congressional)									
Qtr 3 NW	Qtr 4 SE	Section 34	Twnshp 3	Twshp... N	Range 65	Rng E/... W	Actual Latitude (°) 40.18018813		Actual Longitude (°) -104.64725759
Wellbore Sections									
Section Des			Size (in)			Act Top, MD (ftKB)		Act Btm, MD (ftKB)	
SURFACE			12 1/4			10		686	
PRODUCTION			7 7/8			686		7,279	
Casing Strings									
Csg Des			Run Date		OD (in)	Wt/Len (lb/ft)	Grade	Top, MD (ftKB)	MD (ftKB)
Surface			9/4/2005		8 5/8	24.00	J-55	10.0	677.0
Production			9/7/2005		4 1/2	11.60	M-80	10.0	7,272.0
Cement									
Des					Start Date		Top (ftKB)		Btm (ftKB)
SURFACE CASING CEMENT					9/4/2005		10.0		677.0
PRODUCTION CASING CEMENT					9/7/2005		4,060.0		7,272.0
Zone Statuses									
Zone Name	Status Date	Status	Fluid Type	Job				Prod Method	
NIOBRARA	11/30/2006	PR		DRILLING/COMPLETION - ORIGINAL, 9/3/2005...				Flowing	
NIOBRARA	12/20/2021	TA		CIBP, 12/20/2021 06:00					
CODELL	11/30/2006	PR		DRILLING/COMPLETION - ORIGINAL, 9/3/2005...				Flowing	
CODELL	12/20/2021	TA		CIBP, 12/20/2021 06:00					
Perforation Data									
Linked Zone		Bnch/Stg	Entered Shot Total	Top (ftKB)		Btm (ftKB)		Date	
NIOBRARA, ORIGINAL HOLE			108	6,896.00		6,914.00		10/26/2005	
CODELL, ORIGINAL HOLE			56	7,132.00		7,146.00		10/3/2005	
Stimulation Intervals									
Zone				Start Date		Top (ftKB)		Btm (ftKB)	
NIOBRARA, ORIGINAL HOLE				10/26/2005		6,896.0		6,914.0	
CODELL, ORIGINAL HOLE				10/26/2005		7,132.0		7,146.0	
CODELL, ORIGINAL HOLE				10/19/2005					
Other In Hole									
Run Date		Des			Make		OD (in)	Top (ftKB)	Btm (ftKB)
12/20/2021		Cast Iron Bridge Plug w/ 2 SX Cement					4	6,820.0	6,846.0
Logs									
Date		Type				Top, MD (ftKB)		Btm, MD (ftKB)	
9/7/2005		COMPENSATED DENSITY				3,500.0		7,257.0	
9/7/2005		INDUCTION				677.0		7,277.0	
10/3/2005		CEMENT BOND				3,850.0		7,225.0	
12/31/2013		GYRO				10.0		7,050.0	
Plug Back Total Depths									
Date		Type			Com				Depth (ftKB)
11/30/2005		FILL			DRILLED OUT CIFTP				7,229.0
12/16/2014		FILL							7,228.6