


	18		
		5	

Locate
Well
Correctly



File in _____ on Fee and Patented lands and in
_____ on State and School lands, with
OFFICE OF DIRECTOR
OIL AND GAS CONSERVATION COMMISSION,
STATE OF COLORADO

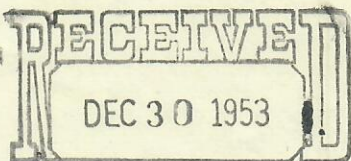

OIL & GAS
CONSERVATION COMMISSION

LOG OF OIL AND GAS WELL

466-1

Field Mt. Hope Company Shell Oil Company
County Logan Address Denham Building, Denver, Colorado
Lease J. F. Kirk 'B'
Well No. 1 Sec. 18 Twp. 9N Rge. 53W Meridian - State or Pat. Pat.
Location 678 Ft. (N) of South Line and 659 Ft. (E) of West line of SE/4 Elevation 4253.7
(Derrick floor relative to sea level)

The information given herewith is a complete and correct record of the well and all work done thereon so far as can be determined from all available records.

Signed [Signature]
Title Division Production Manager

Date December 28, 1953

The summary on this page is for the condition of the well as above date.
Commenced drilling October 29, 1953 Finished drilling November 8, 1953

OIL AND GAS SANDS OR ZONES

No. 1, from None to _____ No. 4, from _____ to _____
No. 2, from _____ to _____ No. 5, from _____ to _____
No. 3, from _____ to _____ No. 6, from _____ to _____

IMPORTANT WATER SANDS

No. 1, from None to _____ No. 3, from _____ to _____
No. 2, from _____ to _____ No. 4, from _____ to _____

CASING RECORD

SIZE	WT. PER FOOT	MAKE	WHERE LANDED	NO. OF SKS. CEMENT	STOOD HOURS	PRESSURE TEST PSI
8 5/8"	28.55	L.P.Casing	597	200		

COMPLETION DATA

Total Depth 5208 ft. Cable Tools from _____ to _____ Rotary Tools from 0 to 5208
Casing Perforations (prod. depth) from None to _____ ft. No. of holes _____
Acidized with 0 gallons. Other physical or chemical treatment of well to induce flow None
Shooting Record None

Prod. began 11-8 1953 Making P&A bbls./day of _____ A. P. I. Gravity Fluid on _____ Pump ☐
Tub. Pres. _____ lbs./sq. in. Csg. Pres. _____ lbs./sq. in. Gas Vol. _____ Mcf. Gas Oil Ratio _____ Choke. ☐
Length Stroke _____ in. Strokes per Min. _____ Diam. Pump _____ in.
B. S. & W. _____ % Gas Gravity _____ BTU's/Mcf. _____ Gals. Gasoline/Mcf. _____

WELL DATA

Indicate (yes or no) whether or not the following information was obtained.
Electrical Log Yes Date 11-7 1953 Straight Hole Survey Yes Type _____
Date _____ 19____ Other Types of Hole Survey Yes Type Microlog
Time Drilling Record Yes (Note—Any additional data can be shown on reverse side.)
Core Analysis None. Depth _____ to _____

FORMATION RECORD

Show all formations, especially all sands and character and contents thereof.

FORMATION	TOP	BOTTOM	REMARKS
	0	610	Surface hole.
	610	4075	Shale.
	4075	4516	Shale and lime.
	4516	4996	Shale.

(Continue on reverse side)

