

Current Wellbore Diagram

API Well No. 05-069-05095

Operator: Brack Drilling Company, Inc.

Well Name: Schureman #1

Wildcat, Larimer County, Colorado

Coordinates: 1980' FSL, 660' FWL NWSW Sec. 34-T8N-R69W 6th PM

Drilled as Dry Hole - P&A 10-20-1956

12-Jan-22

Bore Diameter (Inches)

← 12.625" →

← 7.875" →


Cement Top 0'

8 5/8" 24# Csg @ 240' KB

Cmt to Surface (125 sks)

**Poured 25 sks cmt through
drill pipe, plug from 270' to
195'.**

8 5/8" Cement Bottom 240' KB

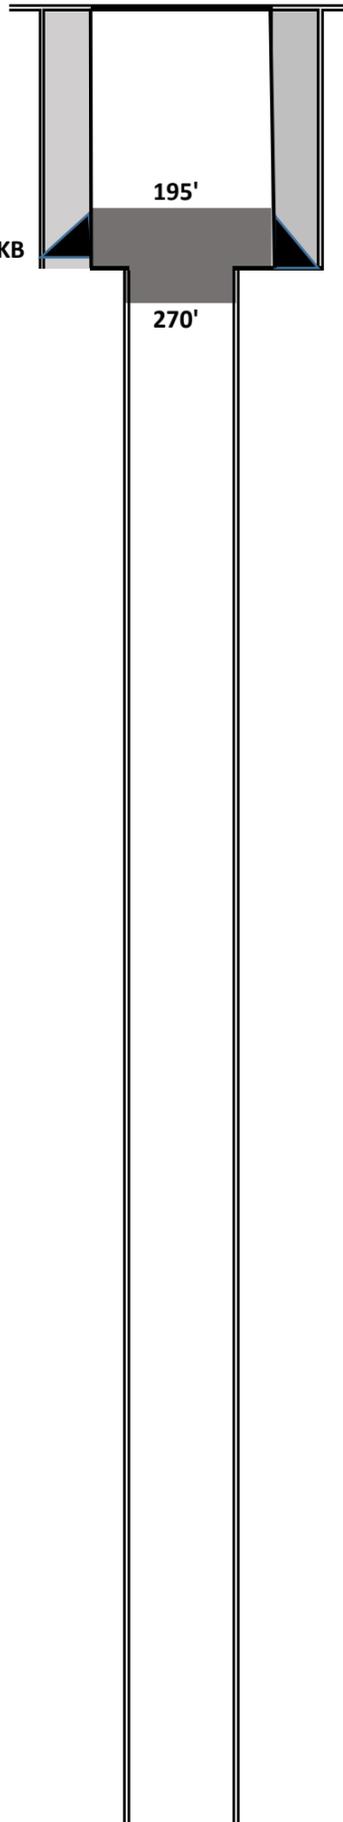

TD = 4090'