




R. 53W

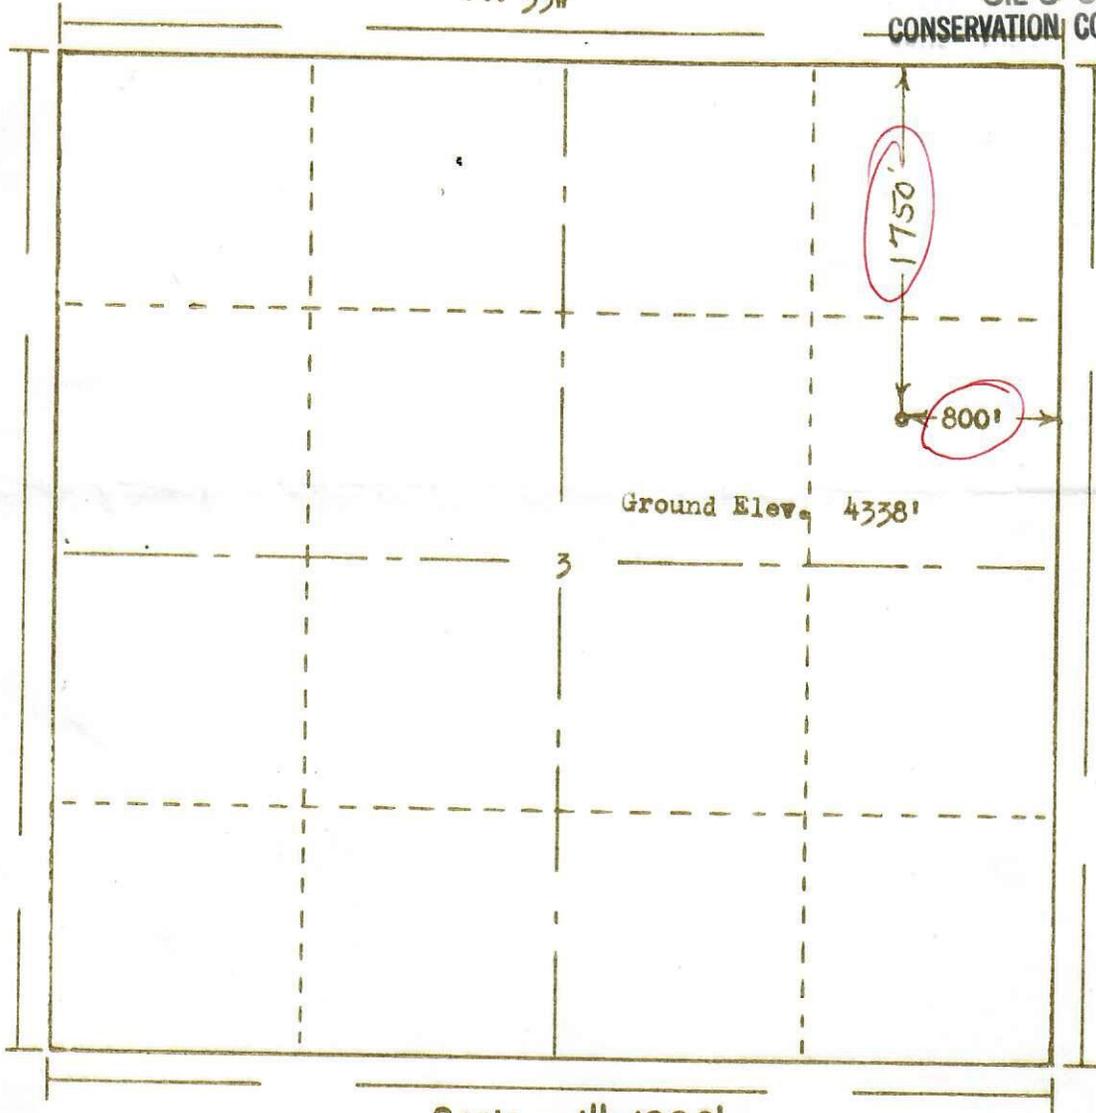

T.
10
N

Scale ... 1" = 1000'

Powers Surveyors, Inc. of Denver, Colorado
has in accordance with a request from Virginia Nowlin
for Stuarco Oil Co., Inc. & Don Winslow determined the
Location of No. 1-C State
to be 1750' FN & 800' FE Section 3 Township 10N
Range 53W of the 6th Principal Meridian
Logan County, Colorado

I hereby certify that this plot is an
accurate representation of a correct
survey showing the location of

Date: 4-23-60

Bert H. Holloman
Licensed Land Surveyor No. 2853
State of Colorado