




RECEIVED

FEB 14 1969

R. 56W

COLO. OIL & GAS CONS. COMM.

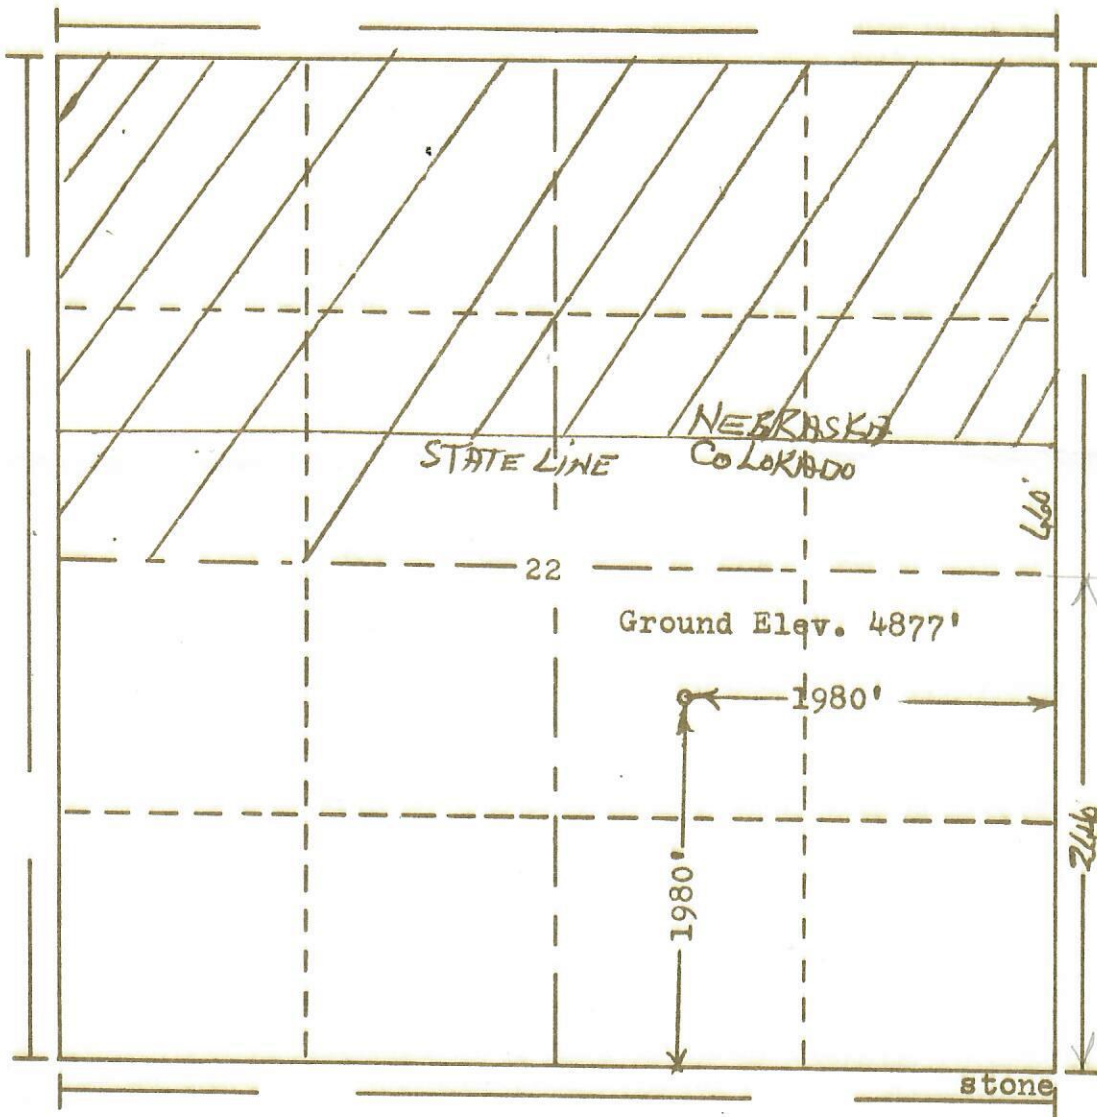

Scale... 1" = 1000'

Powers Elevation Company, Inc. of Denver, Colorado
has in accordance with a request from Mr. Phillips
for Petroleum Inc.

determined the location of No. 3 Buczkowsky
to be CNW SE Section 22 Township 12N
Range 56W of the 6th Principal Meridian
Weld County, Colorado

I hereby certify that this plat is an
accurate representation of a correct
survey showing the location of

Date: 2-6-69

Eric G. Hedman
Licensed Land Surveyor No. 2853
State of Colorado