




R. 56W

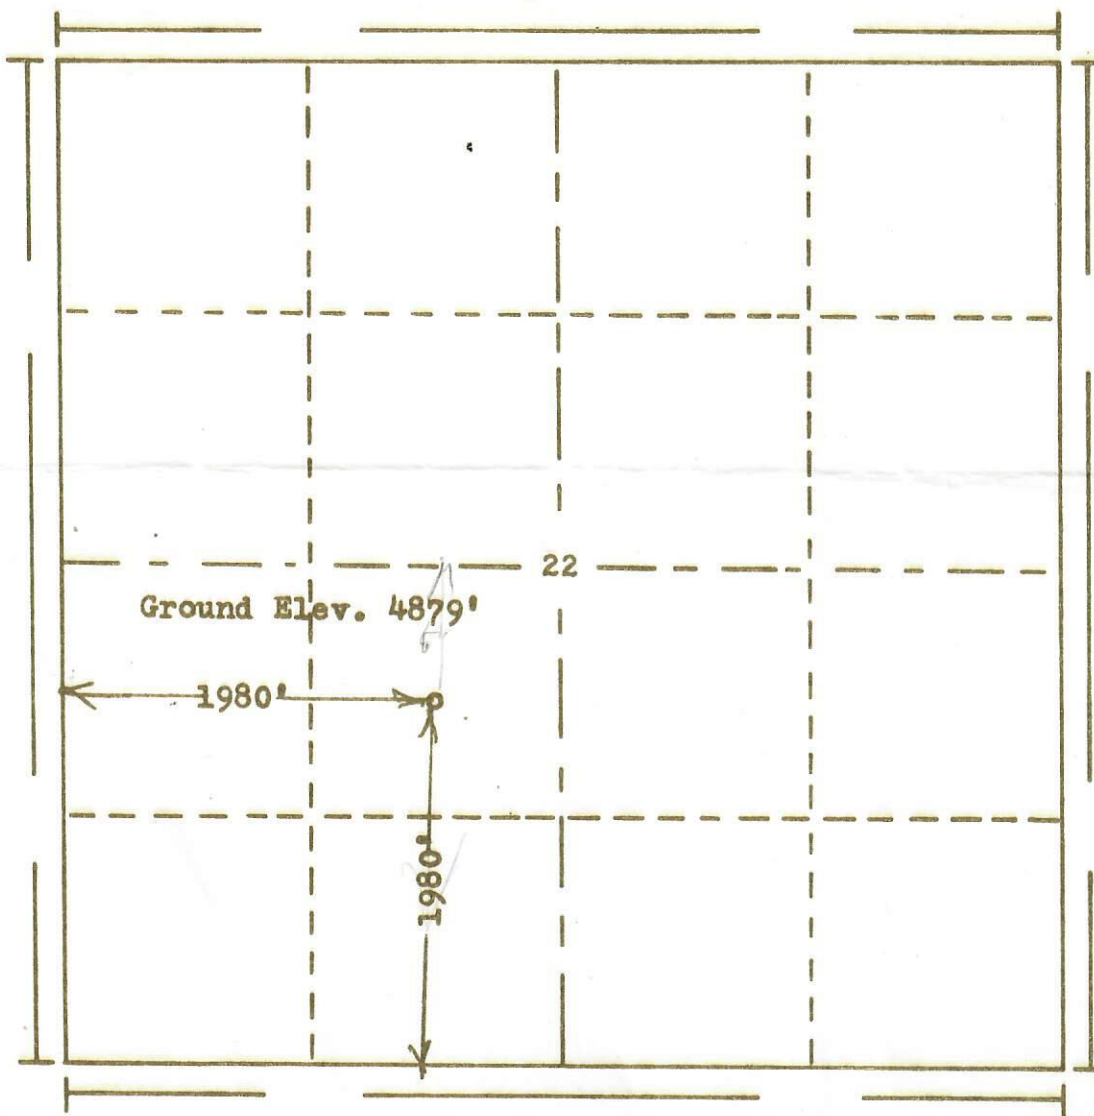

T. 12N

Scale... 1" = 1000'

Powers Elevation Company, Inc. of Denver, Colorado has in accordance with a request from Mr. Wilson for Petroleum Inc.

determined the location of No. 4 Buczkowsky to be CNE SW Section 22 Township 12N Range 56W of the 6th Principal Meridian Weld County, Colorado

I hereby certify that this plat is an accurate representation of a correct survey showing the location of

Date: 5-15-69

B. J. H. H. H.
Licensed Land Surveyor No. 2853
State of Colorado