




OIL AND GAS CONSERVATION COMMISSION OF THE STATE OF COLORADO

NOTICE OF INTENTION TO DRILL

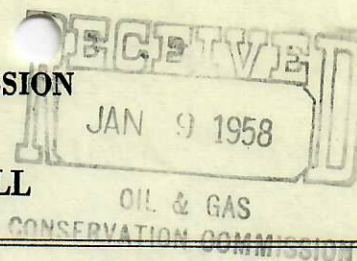

INSTRUCTIONS:

A notice of intention to drill a well shall be filed in duplicate on all Federal and Patented lands, and in triplicate on all State lands. Do not begin operations until approved copy has been received. It is mandatory that the proposed location comply with all rules and regulations of the Commission. Locate well on section grid in proper location, and indicate extent of lease. Unless operations are commenced within 180 days after the date of approval hereof, this approval to drill will become null and void.

Name of Operator NEBRASKA DRILLERS, INC. Phone No. 15
Address Post Office Box 32 City GENEVA State NEBRASKA


How is liability secured: Well Bond (Attached) ☐; Blanket Bond ☒; Waiver ☐
(Check one)

Lease Name CERVERY

Well No. 1

Field Name Wildcat ☒

County WELD ☒

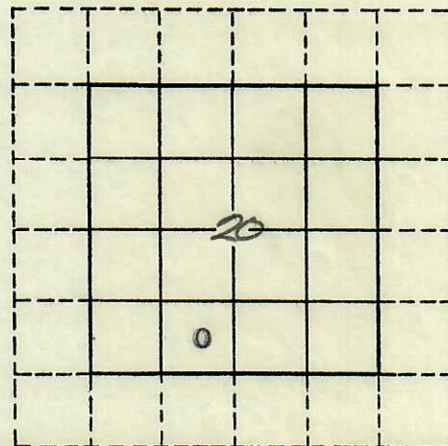

Location C - SE SW Section 20 Township 12N Range 56W Meridian 6TH PM
(quarter quarter)
660 feet from S Section line and 1980 feet from W Section Line
N or S E or W

The well is located on: Patented land ☒ State land ☐ Federal land ☐

The well is located within a spaced area: Yes ☒ No ☐

Distance from proposed location to nearest property or lease line ? feet.

Distance from proposed location to nearest drilling unit line ? feet.

Objectives: "D" Depth 6275; "J" Depth 6375
Formation Estimate Formation Estimate

Proposed length of surface casing 194 feet.

REMARKS:

Agent	<u>OK</u>
Bond	<u>maine</u>
Spot	
600 ft.	
1200 ft.	<u>OK</u>
Wells	
Oil	
Gas	
Status	

I/We hereby swear (or affirm) that the statements herein made are a full and correct report.

APPROVED:

Date JAN 9 1958

A. J. Persinger
Director

Company NEBRASKA DRILLERS, INC. Date JANUARY 3, 1958

Address Box 32, GENEVA, NEBRASKA Phone No. 15

By [Signature] Title PARTNER
Signature