


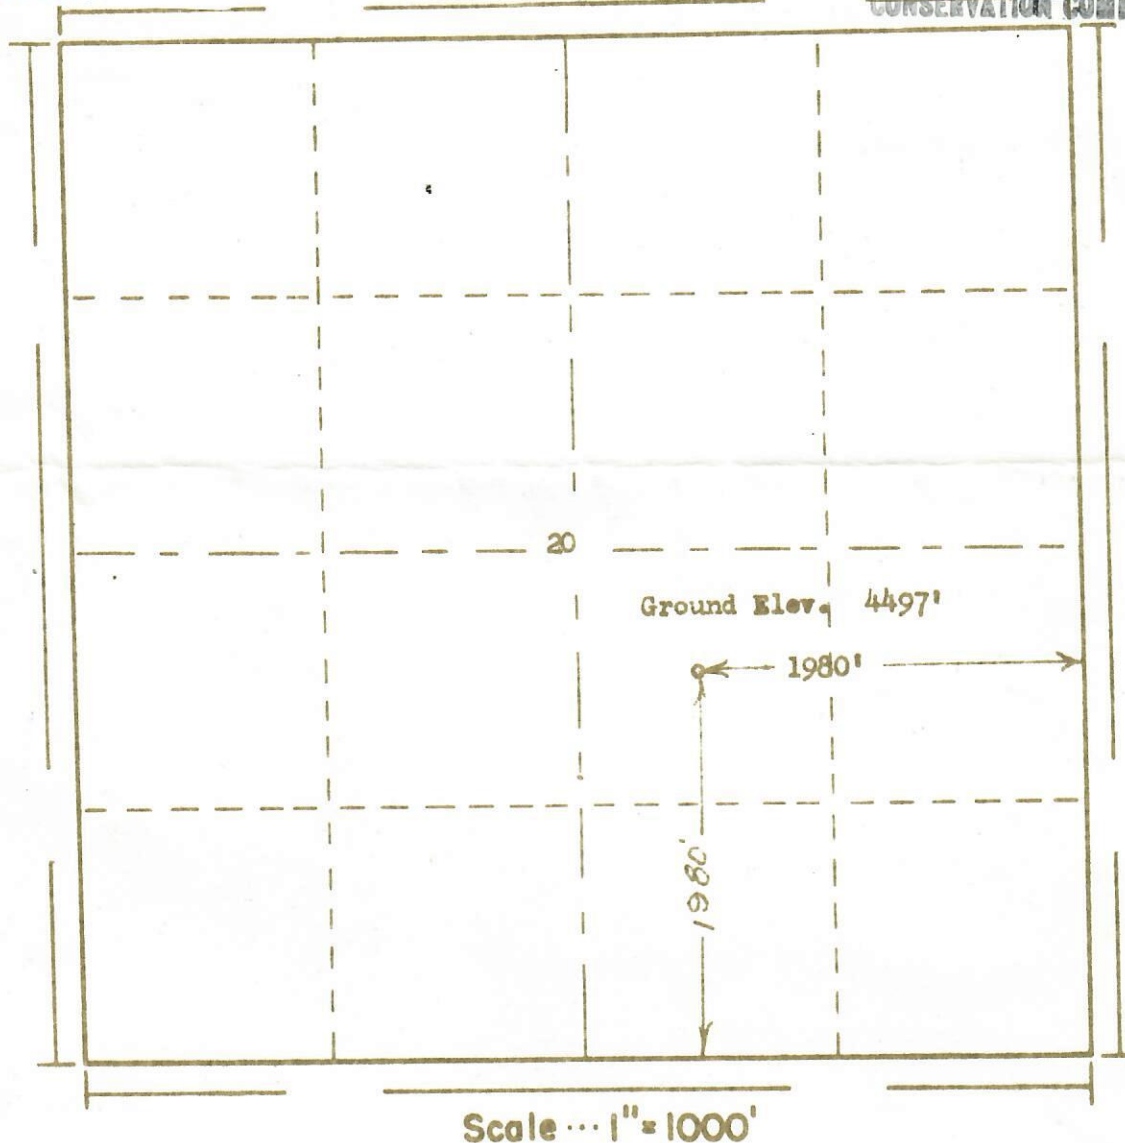

99999999

R. 52W

AUG - 3 1962

OIL & GAS
CONSERVATION COMMISSION

Powers Elevation Company of Denver, Colorado
has in accordance with a request from Mr. Chambers
for Vincent & Welch determined the
Location of No. 1 J. Lael DeLand
to be 1980' FE & 1980' FS Section 20 Township 12N
Range 52W of the 6th Principal Meridian
Logan County, Colorado

The above Plat shows the location of the well site
in said section.

05-075-07307



00823269

Date: 7-31-62

Powers Elevation Company

by: *Billy G. Holloway*

Registered Land Surveyor No. 2853 State of Colorado