




00823736

RECEIVED
APR - 7 1966



R. 55W

OIL & GAS
CONSERVATION COMMISSION

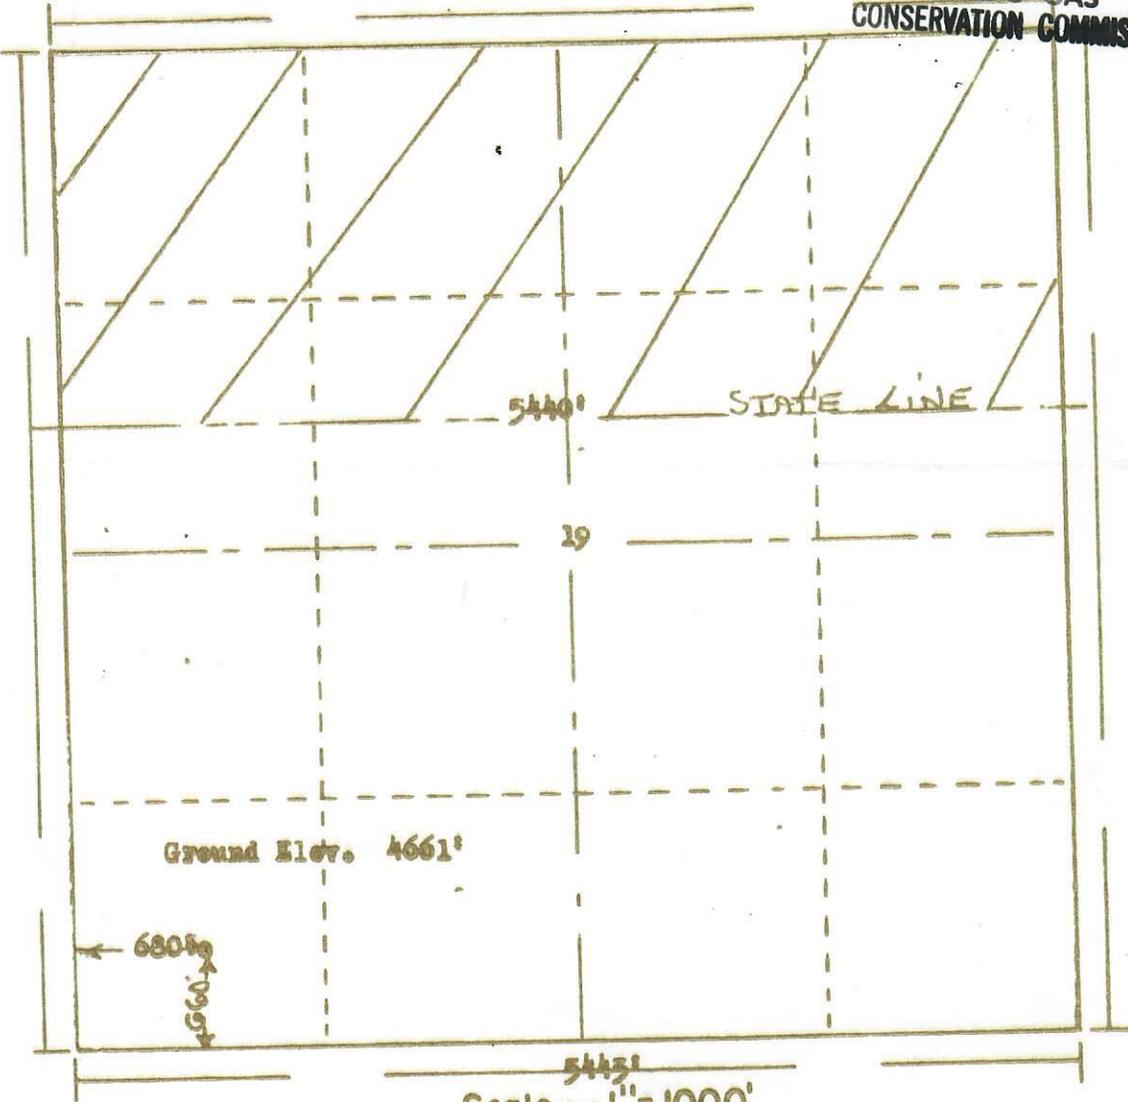

T.
12
N

Scale ... 1" = 1000'

Powers Surveyors, Inc. of Denver, Colorado
 has in accordance with a request from Mr. Simpson
 for Union Texas Petroleum determined the
 Location of No. 1 Herheldsheimer
 to be 05W 8V Section 19 Township 12N
 Range 55W of the 6th Principal Meridian
 Logan County, Colorado

I hereby certify that this plat is an
 accurate representation of a correct
 survey showing the location of

Date: 3-23-66

Bruce G. Holloman
 Licensed Land Surveyor No. 2855
 State of Colorado