




CERTIFICATE OF SURVEY
for
Rex Monahan
Logan County, Colorado

RECEIVED

JUL 23 1985

COLO. OIL & GAS CONS. COMM.

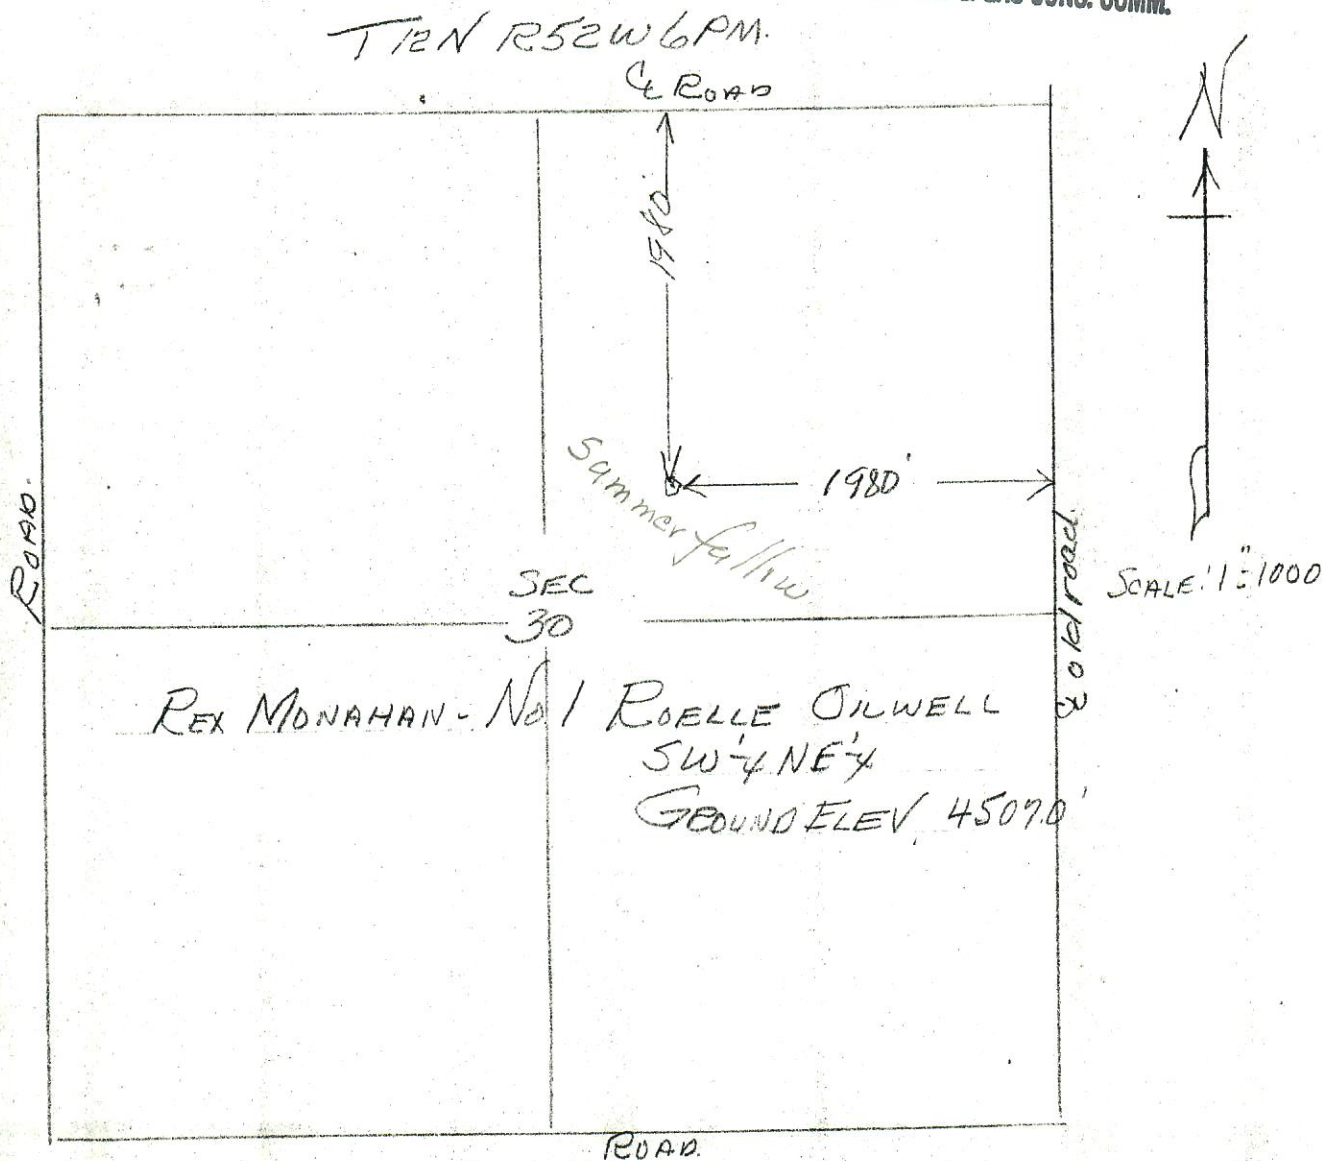

I hereby certify that the above plat is an accurate representation of a correct survey showing the location of Rex Monahan-No.1 Roelle Oilwell in SW 1/4 NE 1/4 Sec. 30 T12N R52W 6PM. The elevation of the ground at the stake is 4507.0 feet above sea level from U.S.G.S. Bench Mark.

Fort Morgan, Colorado
July 3, 1985

Laurel J. Osborne
Registered Professional Engineer
State of Colorado