BISON OIL & GAS

Final - As Plugged Wellbore Schematic

Well Name:	Duell-Campbell 1	Date Prepared:	1/25/2022
Location:	2640 FNL & 660 FWL W2 Sec. 31 T8N R59W	Date Surface Plug Set:	12/18/2021
County	Weld	Date Well Cut & Capped:	12/28/2021
API #:	05-123-05464		
Co-ordinates:	40.618847 / -104.028013		
Elevations:	GROUND: Unknown		
	KB: 4959'		
Depths (KB):	PBTD: --		
	TD: 6930'		

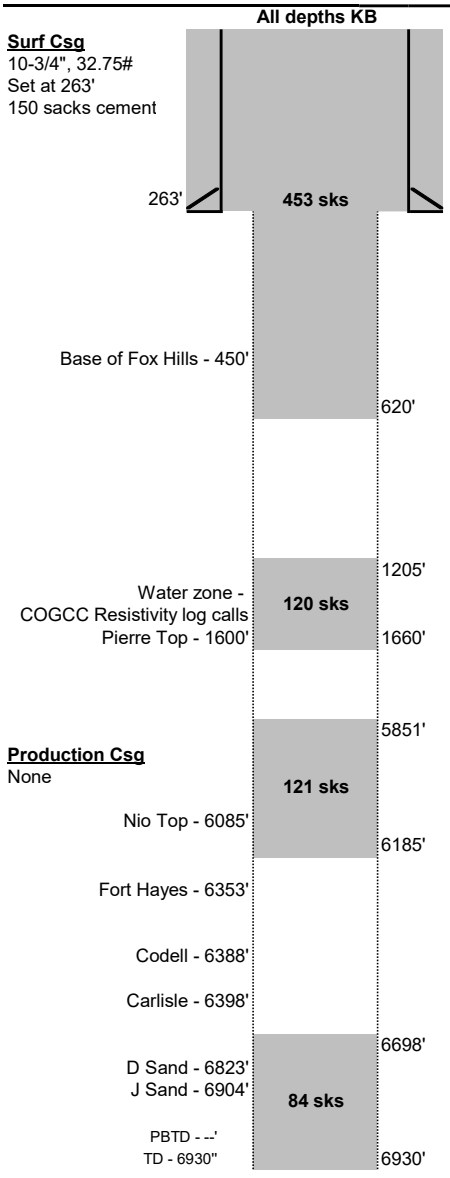

Surface Casing:
Unknown Hole Size, assumed to be 15"
Landed 10-3/4", 32.75# casing at 263'
Cemented with 150 sks

Production Casing:
No production casing

Open Hole:
263'-6930', hole size unknown, likely 8-3/4"

Tubing:
None

Rods:
None

Perforations:
None

P&A Plugs:
1. 84 sks Class G (1.15 cuft/sk) from 6698'-6930' (TOC Estimated)
2. 121 sks Class G (1.15 cuft/sk) from 5851'-6185' (TOC Estimated)
3. 120 sks Class G (1.15 cuft/sk) from 1205'-1650' (TOC Tagged)
4. 453 sks Class G (1.15 cuft/sk) from 620' to surface

Additional Notes:

Initial Potential Test:

Formation Tops:

Niobrara	6085'
Fort Hayes	6353'
Codell	6388'
Carlisle	6398'
D Sand	6823'
J Sand	6904'