

RECEIVED
JUL 21 1960

OIL & GAS
CONSERVATION COMMISSION

OIL AND GAS CONSERVATION COMMISSION
OF THE STATE OF COLORADO

NOTICE OF INTENTION TO DRILL



00264514


INSTRUCTIONS:

A notice of intention to drill a well shall be filed in duplicate on all Federal and Patented lands, and in triplicate on all State lands. Do not begin operations until approved copy has been received. It is mandatory that the proposed location comply with all rules and regulations of the Commission. Locate well on section grid in proper location, and indicate extent of lease. Unless operations are commenced within 180 days after the date of approval hereof, this approval to drill will become null and void.

Name of Operator Cabeen Exploration Corporation Phone No. AMherst 6-1635
Address 945 Petroleum Club Building City Denver 2, State Colorado

How is liability secured: Well Bond (Attached) ; Blanket Bond ; Waiver
(Check one)

Lease Name Whittier
Well No. 2
Field Name _____ Wildcat
County Logan

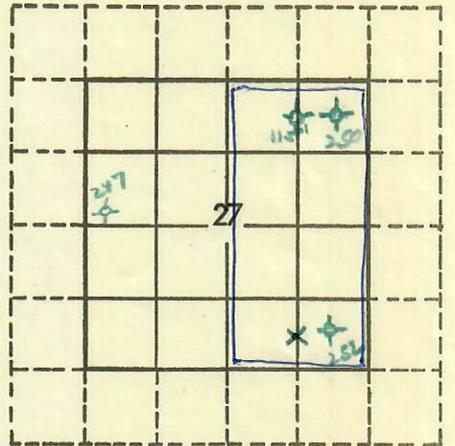

Location C S/2 SE/4 (quarter quarter) Section 27 Township 9N Range 53W Meridian 6th
660 feet from S Section line and 1320 feet from E Section Line
N or S E or W

The well is located on: Patented land State land Federal land

The well is located within a spaced area: Yes No

Distance from proposed location to nearest property or lease line 660 feet.
Distance from proposed location to nearest drilling unit line _____ feet.

Objectives: Dakota "D" Depth 4794; Dakota "J" Depth 4896
Formation Estimate Formation Estimate

Proposed length of surface casing 125 + - feet.

REMARKS:

Agent	<u>ES</u>
Bond	<u>attached</u>
Spot	
600 ft.	<input checked="" type="checkbox"/>
1200 ft.	
Wells	
Oil	
Gas	
Status	

I/We hereby swear (or affirm) that the statements herein made are a full and correct report.

APPROVED:

Date July 21, 1960
[Signature]
Director

Company Cabeen Exploration Corp. Date July 19, 1960
945 Petroleum Club Bldg. AMherst
Address Denver 2, Colorado Phone No. 6-1635
By [Signature] Title Dist. Drlg. & Prod. Mgr.
Signature