



FORM F-106

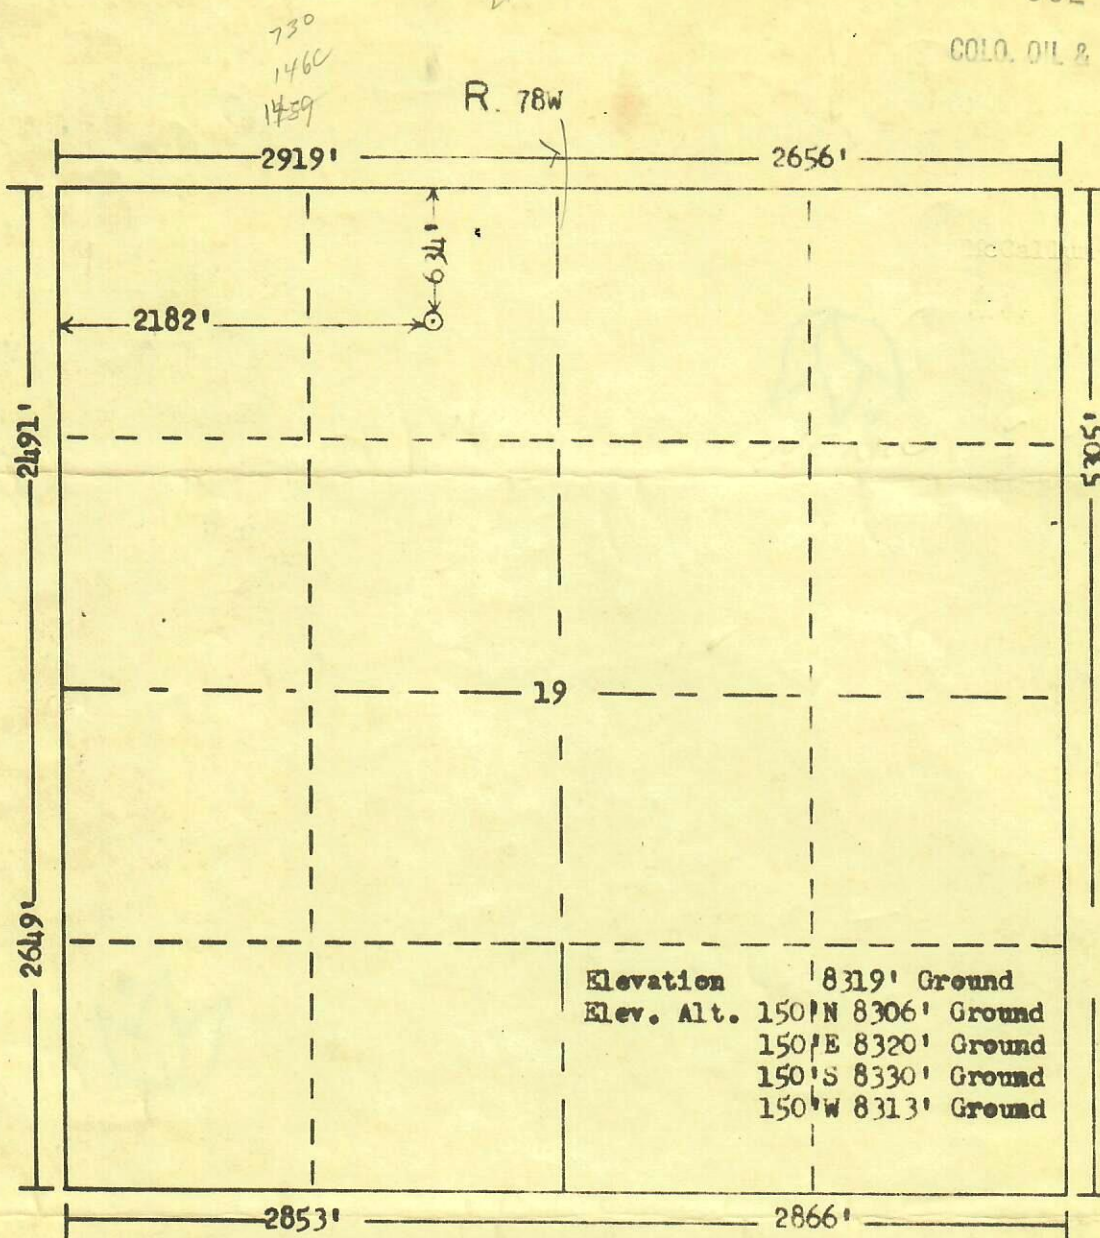


00272406

RECEIVED

JUL 2 1975 N

COLO. OIL &amp; GAS CONS. COMM.

T.  
9  
N

Scale... 1" = 1000'

Powers Elevation Company, Inc. of Denver, Colorado  
has in accordance with a request from Tom Carroll  
for Helmerich & Payne Inc.

determined the location of #1-19 McCallum-Federal  
to be 634' FN & 2182' FW Section 19 Township 9N  
Range 78W of the 6th Principal Meridian  
Jackson County, Colorado

I hereby certify that this plat is an  
accurate representation of a correct  
survey showing the location of  
#1-19 Federal- McCallum

Date: 6-20-75

Licensed Land Surveyor No. 1671  
State of Colorado

*file*

75 572