

## Rangely Weber Sand Unit

## LEVISON 31X Current Wellbore

Well Details:	
STATE & CO	CO - Rio Blanco
TWNS & RNG	TN002 & RW102
SECTION	(NWNW) 26
API	51030735300
CHEVNO	DG2306

Casing Details:	
Type	Depth
KB	5377
GL	5368
16in. 0 #/ft, UNKNOWN	0-45', 0 sxs cmt
10.75in. 40.5 #/ft, K-55	0-761', 525 sxs cmt
7in. 23 #/ft, J-55	0-5429', 0 sxs cmt
7in. 23 #/ft, N-80	5429-6527', 650 sxs cmt
5.5in. 17 #/ft, J-55	0-5998', 165 sxs cmt
Top Perf	6101
Bot Perf	6511
PBTD	6353
TD	6527

Formation	Depth
Niobrara	2474
Frontier	3204
Frontier Snd	3289
Mowry	3480
Dakota	3580
Morrison	3667
Curtis	4270
Entrada	4399
Carmel	4550
Navajo	4587
Chinle	5200
Shinarump	5336
Moenkopi	5420
Weber	6072

KB 5377  
GL 5368  
16in. 0 #/ft, UNKNOWN  
0-45', 0 sxs cmt  
10.75in. 40.5 #/ft, K-55  
0-761', 525 sxs cmt

7in. 23 #/ft, J-55  
0-5429', 0 sxs cmt  
7in. 23 #/ft, N-80  
5429-6527', 650 sxs cmt


5.5in. 17 #/ft, J-55  
0-5998', 165 sxs cmt

GOC_CALC	5707	Cum HCPV
----------	------	----------

Weber 1a	6072	54%	Top Perf 6101
Weber 2	6255		
Weber 3a	6262	65%	
Weber 4	6342		
Weber 5a	6360	99%	PBTD 6353
Weber 6	6476		
Weber 7a	6494	100%	
Weber 8			
Weber 9a		100%	Btm Perf 6511
Weber 10			
Weber 11a		100%	

OWC_CALC	6527
----------	------

TD 6527

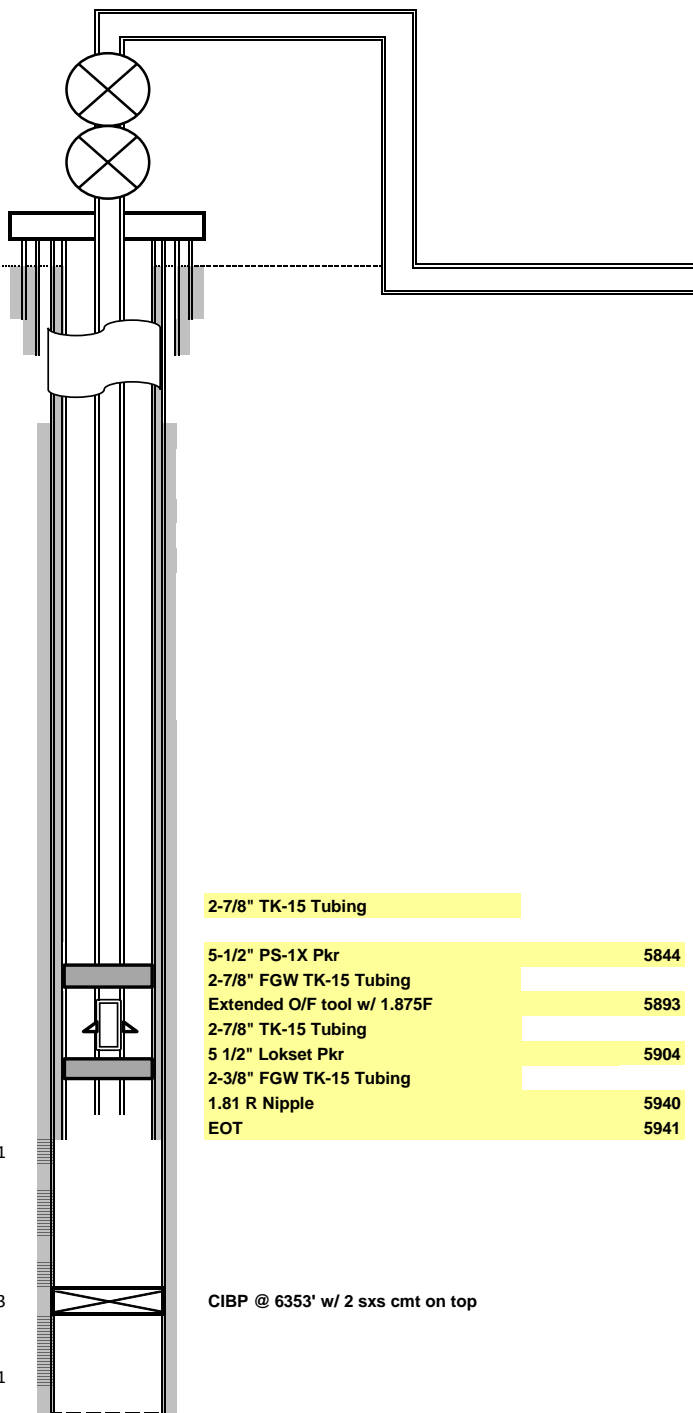

2-7/8" TK-15 Tubing

5-1/2" PS-1X Pkr 5844  
2-7/8" FGW TK-15 Tubing  
Extended O/F tool w/ 1.875F 5893  
2-7/8" TK-15 Tubing  
5 1/2" Lokset Pkr 5904  
2-3/8" FGW TK-15 Tubing  
1.81 R Nipple 5940  
EOT 5941

CIBP @ 6353' w/ 2 sxs cmt on top

\*\*\*\*DOUBLE CHECK TUBING LANDING DETAIL IN WELL/TOUR FILE\*\*\*\*

### Notes:

- 1996 - Repaired 7" casing leaks (now behind 5-1/2" liner) @ 2361'-2376' w/ 125 sxs, 2659'-2565' w/ 125 sxs, 2909'-3033' w. 175 sxs, and 3530'-3846' w/400 sxs
- 
- 
-